

FIELD EVALUATION SHEET

NAME Greg Maas PERMIT # 2016000318
 PARCEL # 29-1-496400 TWP 49-23 SECTION 5

CHECK THE FOLLOWING PRIOR TO INSPECTION

B Hargrave NAME OF SITE EVALUATOR
 _____ NAME OF DESIGNER
 _____ NAME OF INSTALLER

_____ LOT OF RECORD BEFORE 1-21-92 (SL) IR 1-10-95 (NSL), IF NO, ALT.SITE? _____
 _____ SITE PLAN WITH SETBACK DISTANCES AND DIMENSIONS
 _____ ARE ISTS SITES PROTECTED FROM DAMAGE? IF NOT, WHEN _____
 _____ DESIGN _____ PERC TESTS _____ SOIL BORINGS, 2 PER SITE
 _____ NUMBER OF BEDROOMS (INCLUDE POTENTIAL)
 _____ CROSS SECTION SHEET _____ TRENCH DESIGN SHEET
 _____ MOUND DESIGN SHEET _____ OTHER OR PERFORM.
 _____ PRESSURE DISTRIBUTION SHEET _____ PUMP CALC. TEST
 _____ WATER USE CALCULATIONS _____
 _____ GARBAGE DISPOSAL _____ HOT TUB
 _____ EASEMENTS ON LOT, IS ROAD PUBLIC OR PRIVATE SEE DEED/PLAT
 _____ NATURAL LANDSCAPE PROTECTION PLAN

STAKING: BUILDINGS _____, DRAINFIELD _____, BORINGS _____, WELL _____
 BUILDING SETBACKS: ROAD _____, SIDE _____, REAR _____, BLUFF _____,
 LAKE/RIVER _____

COMPLETE DURING SITE EVALUATION
 BUILDINGS STAKED _____ DRAINFIELD STAKED _____ BORINGS STAKED _____
 _____ WELL STAKED

SETBACKS (MEASURE DISTANCE)

| | <u>DRAINFIELD</u> | <u>HOUSE</u> |
|-------------------------------|---------------------|---------------------|
| FLOOD PLAIN | YES/NO | YES/ <u>NO</u> |
| WETLANDS | YES/NO | YES/ <u>NO</u> |
| LAKE, RIVER, PROTECTED WATERS | _____ | _____ |
| ROAD RIGHT OF WAY | _____ | _____ |
| BLUFF | _____ | _____ |
| SIDE LOT LINE | _____ | _____ |
| REAR LOT LINE | _____ | _____ |
| HOUSE OR OTHER STRUCTURE | _____ | _____ |
| WELL | _____ | _____ |
| EASEMENTS | _____ | _____ |
| NEIGHBORING WELL (S) TO ISTS | _____ (1) _____ (2) | _____ (3) _____ (4) |
| DRAINFIELD AREA DISTURBED | _____ | _____ |


see site plan

CONFORMING SEPTIC SYSTEM: YES _____ NO If no, list reasons below.
 COMMENTS OR PROBLEMS (drainage, swales, wetlands, need gutters, etc.) _____

APPROVED: YES OR NO

INSPECTORS NAME Bryan Hargrave DATE 6/5/2016 # PICTURES 10
 SOIL BORING LOGS AND SKETCH PLAN ON REVERSE SIDE

Drawing is approximate!

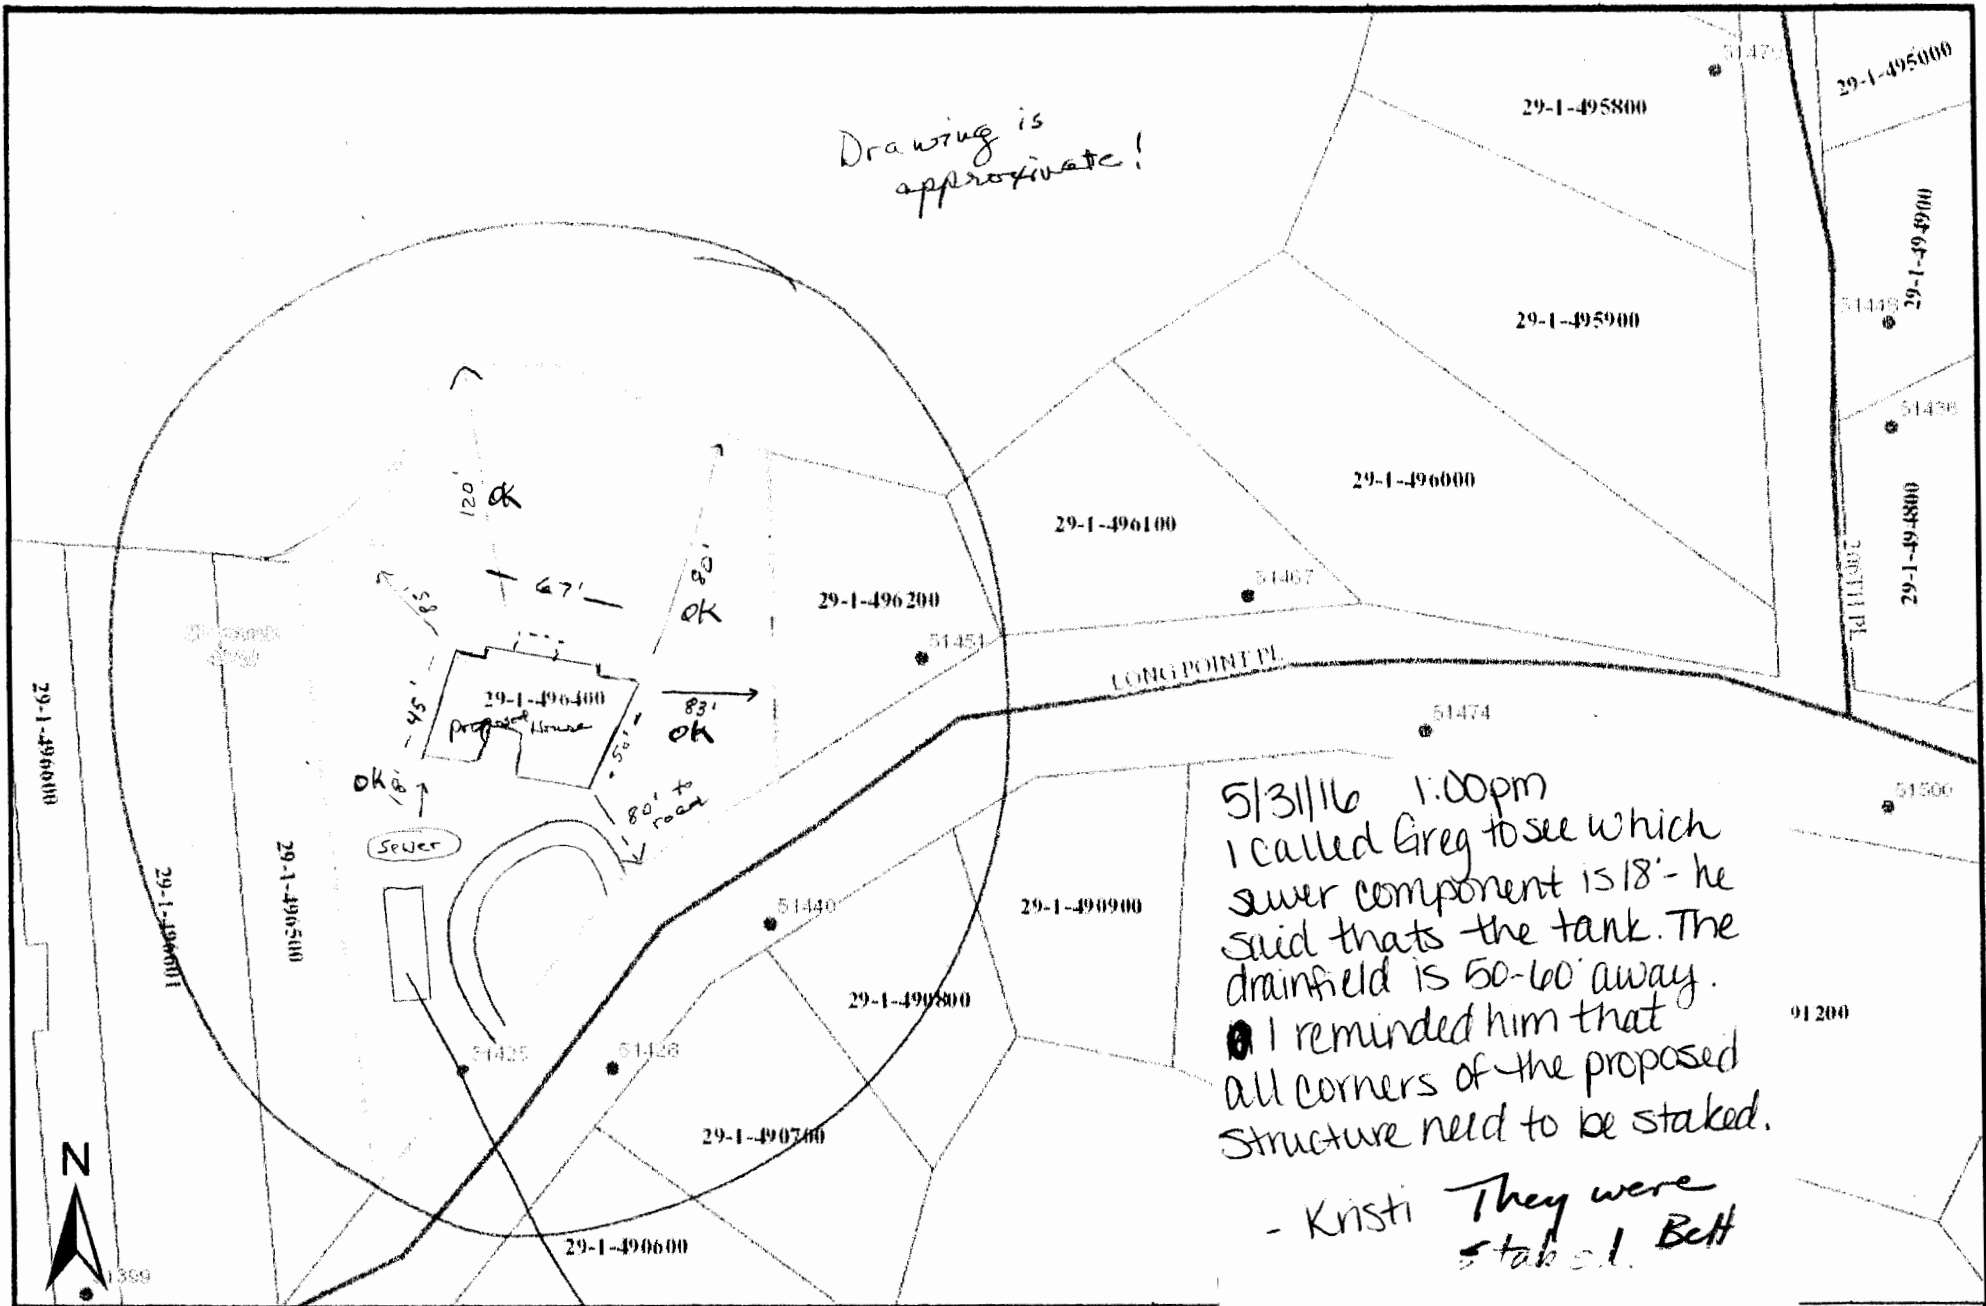

5/31/16 1:00pm
 I called Greg to see which sewer component is 18' - he said that's the tank. The drainfield is 50-60' away.
 I reminded him that all corners of the proposed structure need to be staked.
 - Kristi They were staked. Beth

These data are provided on an "AS-IS" basis, without warranty of any type, expressed or implied, including but not limited to any warranty as to their performance, merchantability, or fitness for any particular purpose.

Current garage 38 x 28

0 45 90 ft 1 inch = 126 feet

Aitkin County

Date: 4/13/2016