

FIELD EVALUATION SHEET

NAME Roger Beane PERMIT # 2016-000281
 PARCEL # 34-1-076700 TWP 43-22 SECTION 24

CHECK THE FOLLOWING PRIOR TO INSPECTION

B. Hargrave NAME OF SITE EVALUATOR
 _____ NAME OF DESIGNER
 _____ NAME OF INSTALLER

- LOT OF RECORD BEFORE 1-21-92 (SL) IR 1-10-95 (NSL), IF NO, ALT.SITE? _____
- _____ SITE PLAN WITH SETBACK DISTANCES AND DIMENSIONS
- _____ ARE ISTS SITES PROTECTED FROM DAMAGE? IF NOT, WHEN _____
- _____ DESIGN _____ PERC TESTS _____ SOIL BORINGS, 2 PER SITE
- _____ NUMBER OF BEDROOMS (INCLUDE POTENTIAL)
- _____ CROSS SECTION SHEET _____ TRENCH DESIGN SHEET
- _____ MOUND DESIGN SHEET _____ OTHER OR PERFORM.
- _____ PRESSURE DISTRIBUTION SHEET _____ PUMP CALC. TEST
- _____ WATER USE CALCULATIONS _____
- _____ GARBAGE DISPOSAL _____ HOT TUB
- _____ EASEMENTS ON LOT, IS ROAD PUBLIC OR PRIVATE SEE DEED/PLAT
- _____ NATURAL LANDSCAPE PROTECTION PLAN

STAKING: BUILDINGS _____, DRAINFIELD _____, BORINGS _____, WELL _____
 BUILDING SETBACKS: ROAD _____, SIDE _____, REAR _____, BLUFF _____,
 LAKE/RIVER _____

COMPLETE DURING SITE EVALUATION

BUILDINGS STAKED _____ DRAINFIELD STAKED _____ BORINGS STAKED _____
 _____ WELL STAKED

SETBACKS (MEASURE DISTANCE)

	<u>DRAINFIELD</u>	<u>HOUSE</u>
FLOOD PLAIN	YES/NO	YES/NO
WETLANDS	YES/NO	YES/NO
LAKE, RIVER, PROTECTED WATERS	_____	_____
ROAD RIGHT OF WAY	_____	_____
BLUFF	_____	_____
SIDE LOT LINE	_____	_____
REAR LOT LINE	_____	_____
HOUSE OR OTHER STRUCTURE	_____	_____
WELL	_____	_____
EASEMENTS	_____	_____
NEIGHBORING WELL (S) TO ISTS	(1) _____ (2) _____	(3) _____ (4) _____
DRAINFIELD AREA DISTURBED	_____	_____

See site Plan

CONFORMING SEPTIC SYSTEM: HT YES _____ NO If no, list reasons below.

COMMENTS OR PROBLEMS (drainage, swales, wetlands, need gutters, etc.)


I will approve HT (T2) for site due to lot configuration, well config. etc.

APPROVED: YES OR NO



INSPECTORS NAME Bryan Hargrave DATE 5/26/2015 # PICTURES 12

SOIL BORING LOGS AND SKETCH PLAN ON REVERSE SIDE

612-419 4913

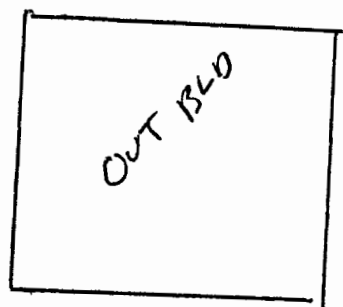


~~12454~~ ROGER BEANE
DW
12454-11TH AVE FINLAYSON
55735

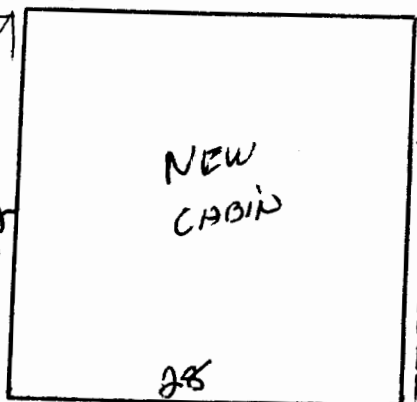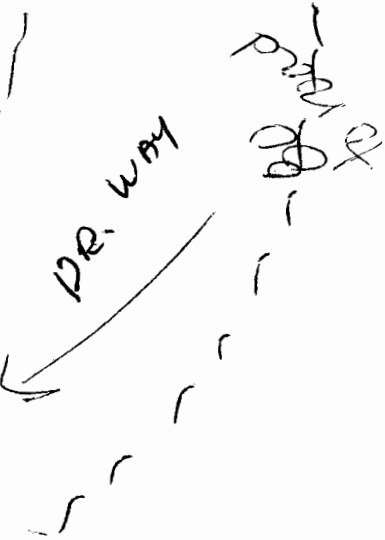

OK 51

OLD DRAIN FIELD
CUT OFF

50' +

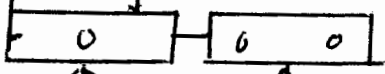

OLD TANK
GOOD
1500

NEW TANK
1500

30' +

LOT LINE

PINE LAKE

NO PLACE TO PUT
NEW SEWER.

Denny Schlotter

320 384 2911

Lic # 1106

* Bryan verify soils
(fill on lot)