

**FIELD EVALUATION SHEET**

NAME Daniel Hoch PERMIT # 2016-000286  
 PARCEL # 29-1-352600 TWP 49-23 SECTION 3

**CHECK THE FOLLOWING PRIOR TO INSPECTION**

B. Hargrave NAME OF SITE EVALUATOR  
 \_\_\_\_\_ NAME OF DESIGNER  
 \_\_\_\_\_ NAME OF INSTALLER

- LOT OF RECORD BEFORE 1-21-92 (SL) IR 1-10-95 (NSL), IF NO, ALT. SITE? \_\_\_\_\_
- \_\_\_\_\_ SITE PLAN WITH SETBACK DISTANCES AND DIMENSIONS
- \_\_\_\_\_ ARE ISTS SITES PROTECTED FROM DAMAGE? IF NOT, WHEN \_\_\_\_\_
- \_\_\_\_\_ DESIGN \_\_\_\_\_ PERC TESTS \_\_\_\_\_ SOIL BORINGS, 2 PER SITE
- \_\_\_\_\_ NUMBER OF BEDROOMS (INCLUDE POTENTIAL)
- \_\_\_\_\_ CROSS SECTION SHEET \_\_\_\_\_ TRENCH DESIGN SHEET
- \_\_\_\_\_ MOUND DESIGN SHEET \_\_\_\_\_ OTHER OR PERFORM.
- \_\_\_\_\_ PRESSURE DISTRIBUTION SHEET \_\_\_\_\_ PUMP CALC. TEST
- \_\_\_\_\_ WATER USE CALCULATIONS \_\_\_\_\_
- \_\_\_\_\_ GARBAGE DISPOSAL \_\_\_\_\_ HOT TUB
- \_\_\_\_\_ EASEMENTS ON LOT, IS ROAD PUBLIC OR PRIVATE SEE DEED/PLAT
- \_\_\_\_\_ NATURAL LANDSCAPE PROTECTION PLAN

STAKING: BUILDINGS \_\_\_\_\_, DRAINFIELD \_\_\_\_\_, BORINGS \_\_\_\_\_, WELL \_\_\_\_\_  
 BUILDING SETBACKS: ROAD \_\_\_\_\_, SIDE \_\_\_\_\_, REAR \_\_\_\_\_, BLUFF \_\_\_\_\_  
 LAKE/RIVER \_\_\_\_\_

COMPLETE DURING SITE EVALUATION  
 BUILDINGS STAKED \_\_\_\_\_ DRAINFIELD STAKED \_\_\_\_\_ BORINGS STAKED \_\_\_\_\_  
 \_\_\_\_\_ WELL STAKED

**SETBACKS (MEASURE DISTANCE)**

	<u>DRAINFIELD</u>	<u>HOUSE</u>
	YES/NO	YES/NO
FLOOD PLAIN	_____	_____
WETLANDS	YES/NO	YES/NO
LAKE, RIVER, PROTECTED WATERS	_____	_____
ROAD RIGHT OF WAY	_____	_____
BLUFF	_____	_____
SIDE LOT LINE	_____	_____
REAR LOT LINE	_____	_____
HOUSE OR OTHER STRUCTURE	_____	_____
WELL	_____	_____
EASEMENTS	_____	_____
NEIGHBORING WELL (S) TO ISTS	_____ (1) _____ (2)	_____ (3) _____ (4)
DRAINFIELD AREA DISTURBED	_____	_____

*see site plan*

CONFORMING SEPTIC SYSTEM:  YES \_\_\_\_\_ NO If no, list reasons below.  
 COMMENTS OR PROBLEMS (drainage, swales, wetlands, need gutters, etc.) \_\_\_\_\_


APPROVED: YES OR NO

INSPECTORS NAME Bryan Hargrave DATE 6/2/2016 # PICTURES 8

SOIL BORING LOGS AND SKETCH PLAN ON REVERSE SIDE

Red & White Marker on North (Pin)  
Property line

2 Lots  
29-1-352500  
29-1-352600

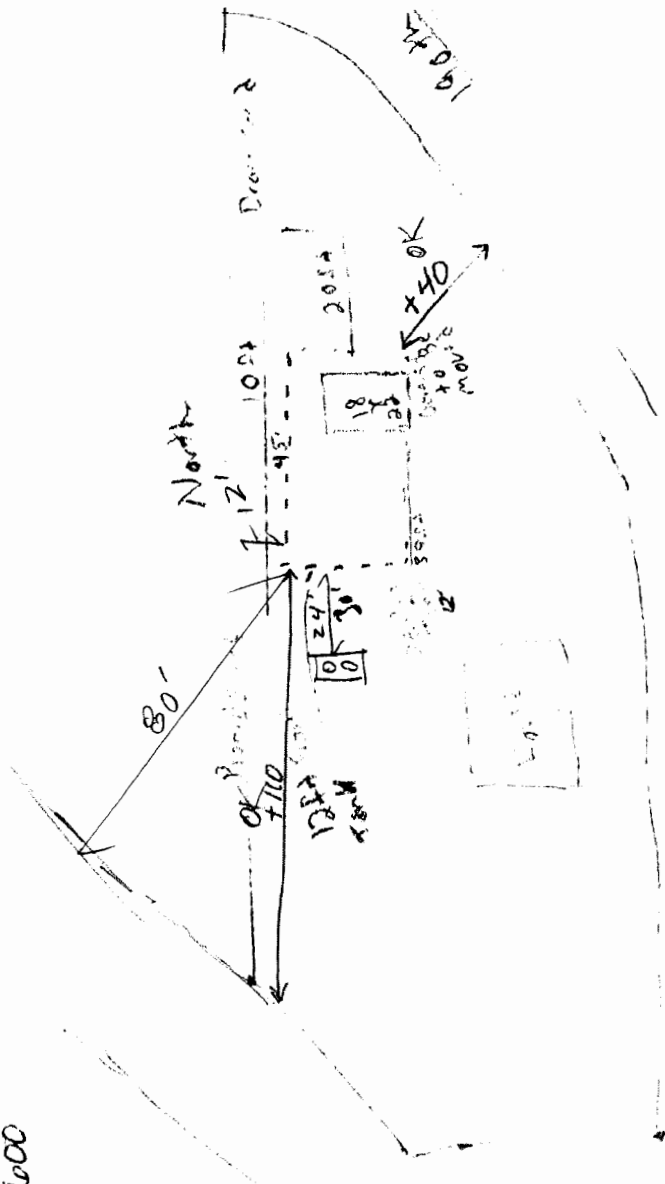

Red & White Marker on North (Pin)  
Property line

Current Garage  
From Septic Tank  
- 39ft - + 18' Garage 57'  
- 10ft Septic Tank  
47ft

45 x 30 x 10  
10ft Garage

5' 0" 190th  
Diane McGowan

29-1-352600