

AITKIN COUNTY
CERTIFICATE OF INSTALLATION/NOTICE OF NONCOMPLIANCE

This certificate of installation/notice of noncompliance has been issued this 11 day of April, 2016 to certify compliance noncompliance with Aitkin County's Subsurface Sewage Treatment System Ordinance.

The premises covered by this certificate are legally described as: Part of Lot 1 NE of Sec 16 NW

Section 27 Township 49 Range 25 Lake Mississippi
PERMIT NO. 41839 Owner Name _____
Address 510 Marconi St
Installer Name Septic Check
Type of System Inspected HT For Pump Station
Parcel Number 60-0-001700

The certificate of installation/notice of noncompliance was based on No 1 of the following:

- 1) Inspection of the installation or construction as in accordance with the above referenced permit and application design.
- 2) Review of as-built plans submitted in accordance with Subdivision 9.2 D of Aitkin County's Subsurface Sewage Treatment System Ordinance.

If the above permitted subsurface sewage treatment system is in noncompliance with Aitkin County's Subsurface Sewage Treatment System Ordinance, then the following shall serve as a Notice of Violation:

- 1) Statement of the findings of fact through inspections or investigations:

2) List of specific violations of Ordinance: _____

3) Requirements for correction or removal of violations: _____

4) Time schedule for compliance: _____

Failure to correct or remove the above violation(s) will result in this matter being turned over to the Aitkin County Attorney's Office for further legal action, which may result in revocation of licenses or registrations, fines and/or imprisonment.

INSPECTOR SIGNATURE RA

INDIVIDUAL SEWAGE TREATMENT SYSTEM INSPECTION FORM
AITKIN COUNTY, MINNESOTA


Township City of Palisade Date of Inspection 4/11-16 Permit Number 41339
Owner Aitkin County Parcel Number 60-0-001700
Project Address 510 Marconi St Installer Syptic Check
City Palisade Zip Code 56469

New Repair

SETBACKS:
Buildings to tank(s) NA
Buildings to drainfield
Well(s) 50' or 100' +150
Lake/Creek/Wetland R.V.A.

SEPTIC TANKS: New Existing
Number of tanks installed 1
Liquid capacity and type Wilbert 1500
Type of baffle plast. <
Inspection pipes level indicator
Manholes size 2
Manhole to grade Yes No

PUMPS: New Existing
Tank capacity and type
Pump manufacturer & model #
Horsepower & GPM
Feet of head
Gallons per cycle
Size of discharge line
Type & location of alarm
Water meter

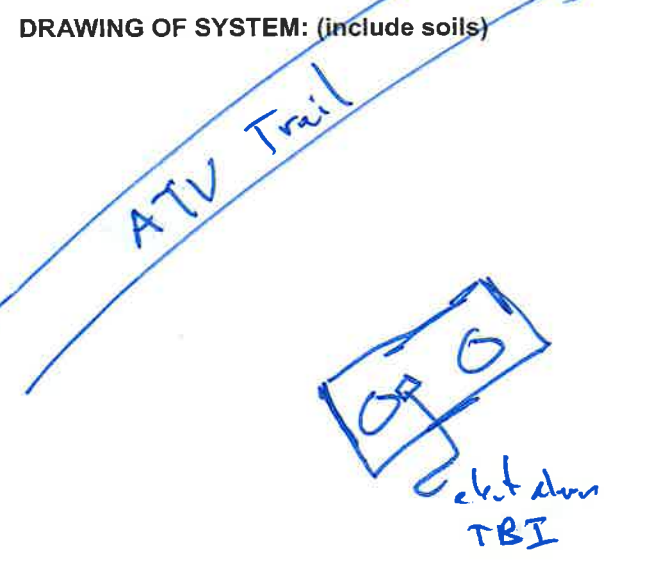

DIST. or DROP BOX & TYPE

TRENCHES, BEDS, OR GRAVELLESS LEACHFIELD:
Trench depth
Trench length
Trench bottom width
Trench spacing
Drainfield rock below pipe
Size of gravelless pipe
Depth of backfill
Absorption area: square feet
lineal feet

MOUNDS:
Percent slope
Upslope dike width
Downslope dike width
Sideslope dike width
Drainfield rock below pipe
Depth of sand below rock
Perforation size & spacing
Pipe size & spacing
Dimensions of rock bed
Dimensions of sand base
Final cover



Inspector's Comments: Fluo Alarm to be installed

Inspector's Signature PN Installer's Signature