
FIELD EVALUATION SHEET

NAME	Kevin Cardinal		PERMI'	_		
PARCEL#	11-1-108400	TW	P 45-2	SECTIO	N 25	
CHECK THE F	OLLOWING PRIOR TO	INSPECTIO)N			
	B. Hargrave		IAME OF SIT	TE EVALUATOR		
			IAME OF DE	SIGNER		
		N	IAME OF INS	STALLER		
/				(NICE) ICNO ALC	CIMPO	
	T OF RECORD BEFORE				SILE?	
	TE PLAN WITH SETBAC					
	RE ISTS SITES PROTECT					
	SIGNPERC TE				IIL	
	MBER OF BEDROOMS (INCLUDE			ION CHEET	
	OSS SECTION SHEET			TRENCH DES		
MOUND DESIGN SHEET PRESSURE DISTRIBUTION SI		CHOCO		OTHER OR PERFORM. PUMP CALC, TEST		
				PUMP CALC	. IESI	
w	ATER USE CALCULATIO	באיַ	IIOT 7	PVID.		
	GARBAGE DISPOSA	L E BOAL		UB D DDIVATE SEE	DEED/DLAT	
	EASEMENTS ON LO				DEED/PLAT	
	NATURAL LANDSC	APE PROT	EC HON PLA	*17		
STAKING.	RIII DINCS D	DAINEIEI	n 19.	ODINGS	WELL.	
RUULDING SET	BUILDINGS, D 「BACKS: ROAD	SIDE	DEAD	RLUFF	, WEEL	
DOILDING SE	LAKE/RIVER		, KEAK_	,		
COMPLETE D	URING SITE EVALUATION					
	STAKEDDRAINFII		ED BC	DRINGS STAKED		
WELL S						
SETBACKS (M	EASURE DISTANCE)					
`	ŕ	DR.	INFIELD	HOUSE		
FLOOD PLAIN		Y	ES/NO	YESONO		
WETLANDS		Y	ES/NO	YESONO		
LAKE, RIVER,	PROTECTED WATERS				1	
ROAD RIGHT					COPC	
BLUFF		·			Sees	
SIDE LOT LIN	E				Plan	
REAR LOT LIN	ie				1	
HOUSE OR OT	HER STRUCTURE					
WELL						
EASEMENTS						
	G WELL (S) TO ISTS	(1)	(2)	(3)	(4)	
	AREA DISTURBED		, ,		` ′	
CONFORMING	SEPTIC SYSTEM:	V YE	<u>s</u>	NO If no, list rea	sons below.	
	R PROBEMS (drainage, sv					
	(umge, 3	,	, 6444			
APPROVED: Y	ÉS OR NO					
II ROVED.				, ,		
INSPECTORS N	NAME Dryan Ha	Ma Bu	DATE	6/13/2016 # PI	CTURES //	
LC LORS I	The lost	-grown	DATE	WIN WIE HE	CIURES 10	
	SOIL BORING LOGS AN	//		•		

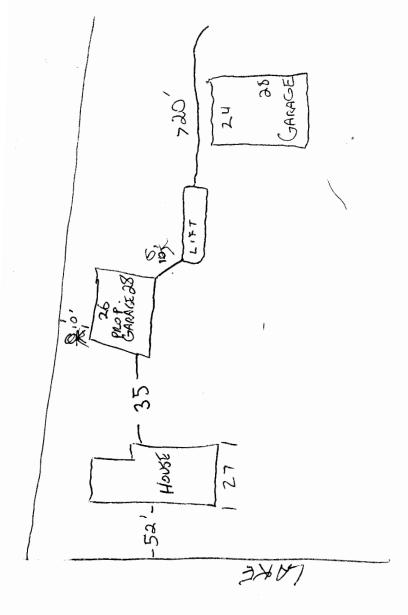

• .