

# FIELD EVALUATION SHEET

PRELIMINARY EVALUATION DATE 3/30/2016, FIELD EVALUATION DATE 3/30/2016  
 PROPERTY OWNER: Ryan Erickson PHONE 763-458-3700  
 ADDRESS: 27248 437<sup>th</sup> Place CITY, STATE, ZIP: Aitkin, Mn. 56431  
 LEGAL DESCRIPTION: \_\_\_\_\_  
 PIN# 11-1-087100 SEC 4 T 45 R 27 TWP NAME Hazelton  
 FIRE# \_\_\_\_\_ LAKE/RIVER Farm Island LAKE CLASS Rec OHWL \_\_\_\_\_ FT.

## DESCRIPTION OF SOIL TREATMENT AREAS

<u>Holding Tank</u>	<b>AREA #1</b>	<b>AREA #2</b>	
DISTURBED AREAS	YES ___ NO ___	YES ___ NO ___	REFERENCE BM ELEV. <u>100</u> FT.
COMPACTED AREAS	YES ___ NO ___	YES ___ NO ___	REFERENCE BM DESCRIPTION _____
FLOODING	YES ___ NO ___	YES ___ NO ___	<u>Corner of house</u>
RUN ON POTENTIAL	YES ___ NO ___	YES ___ NO ___	<u>Tank inlet approx. at 98 ft.</u>
SLOPE %	_____	_____	_____
DIRECTION OF SLOPE	_____	_____	_____
LANDSCAPE POSITION	_____	_____	_____
VEGETATION TYPES	<u>Grass</u>		

DEPTH TO STANDING WATER OR MOTTLED SOIL: BORING# 1 \_\_\_\_\_, 1A \_\_\_\_\_, 2 \_\_\_\_\_, 2A \_\_\_\_\_

BOTTOM ELEVATION—FIRST TRENCH OR BOTTOM OF ROCK BED: #1 \_\_\_\_\_ FT., #2 \_\_\_\_\_ FT.

SOIL SIZING FACTOR: SITE #1 \_\_\_\_\_, SITE #2 \_\_\_\_\_

CONSTRUCTION RELATED ISSUES: No room on property for a standard system as long as shallow well exists. An 1860 gal. 2 compartment tank will be installed. If a new well is ever installed its possible a new system could be added and meet the required set backs without adding or changing this tank  
 LIC# 22132 SITE EVALUATOR SIGNATURE: Tom O'Neil

SITE EVALUATOR NAME: Tom O'Neil TELEPHONE# 218-927-6070

LUG REVIEW (KT) DATE 3-31-16

Comments: \_\_\_\_\_  
 \_\_\_\_\_  
 \_\_\_\_\_

SOIL BORING LOGS ON REVERSE SIDE

**APPROVED**

ONSITE INSPECTION  
 NO ONSITE INSPECTION

SIGN (KT) DATE 3-31-16

Ryan Erickson

[Redacted]


27248 - 437th Place  
Aitkin, MN 56431  
763-458-3700

PID # 11-1-087100  
W 1/2 of Lots 35 & 36  
Plat of Farm Island Beach



1" = 20'

All elevations at grade

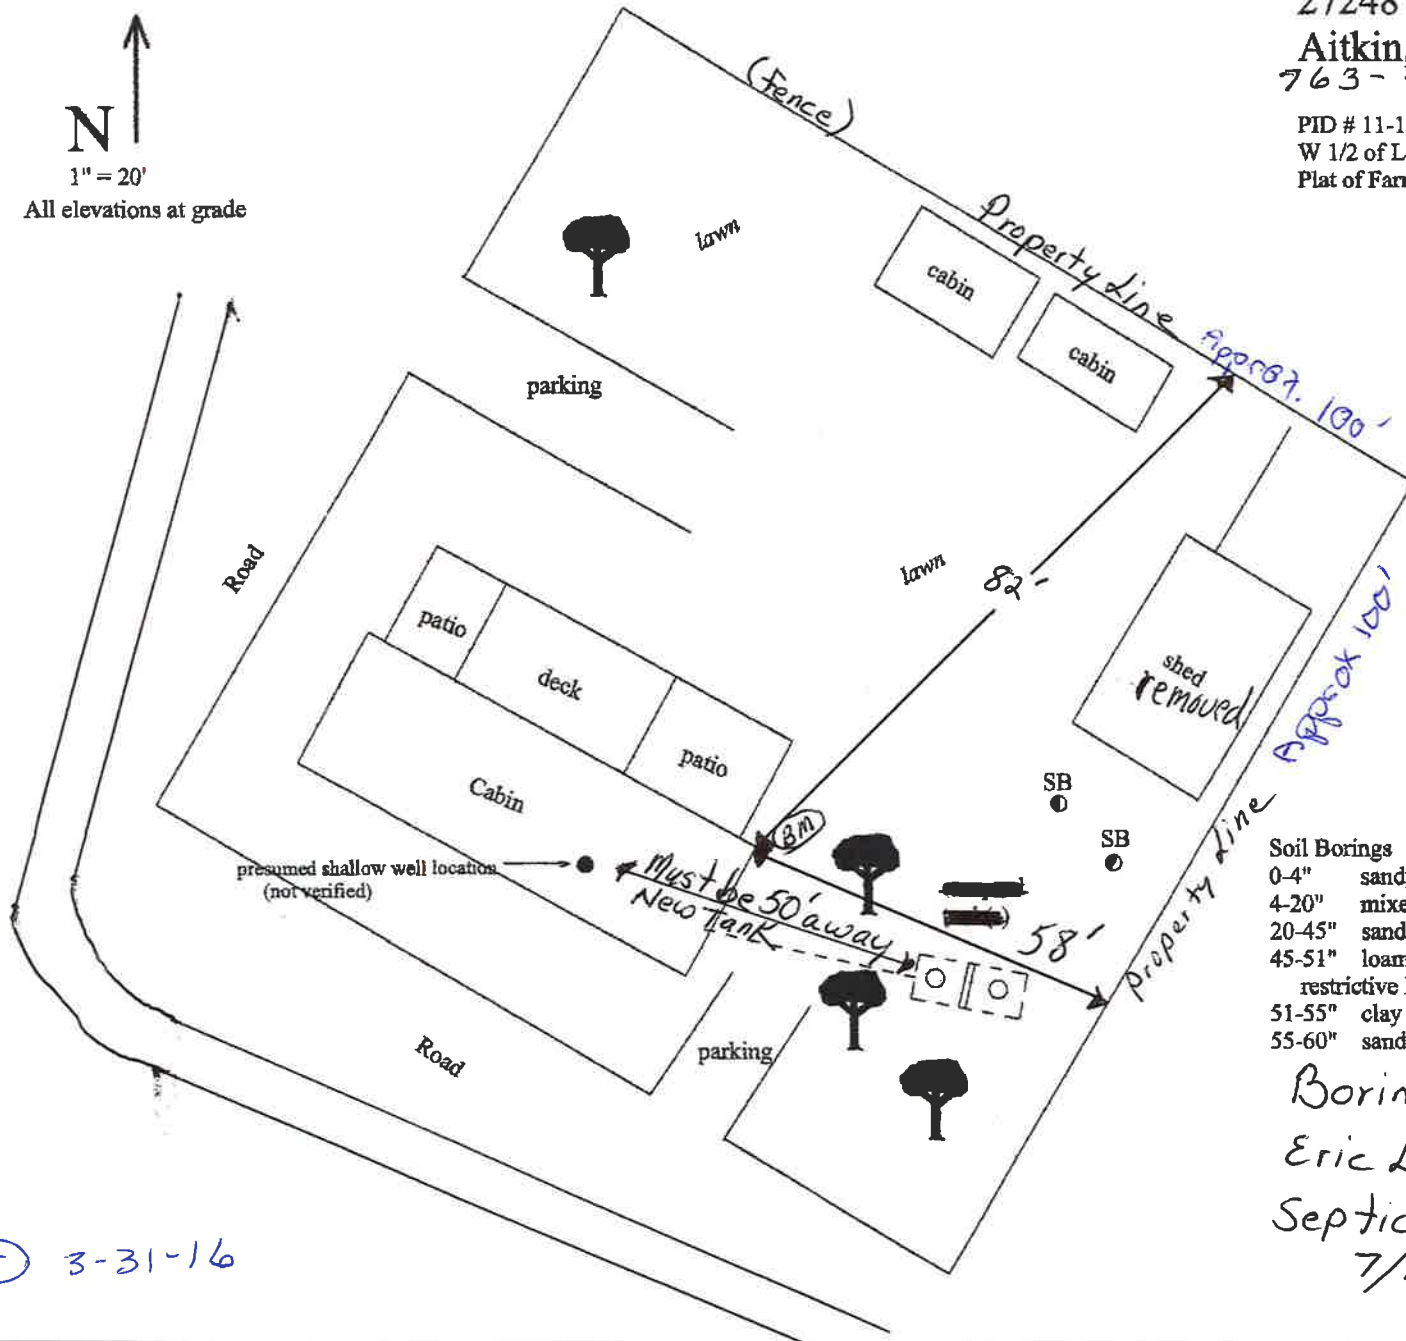

no room on property for a septic system as long as the shallow well exists

Soil Borings

0-4"	sandy loam	10YR 3/2
4-20"	mixed sands	10YR 3/3, 3/2, 4/4
20-45"	sand	10YR 4/4
45-51"	loam w/reodox	10 YR 4/4
restrictive layer 45"		
51-55"	clay loam	7.5YR 4/4
55-60"	sand	10YR 4/4

Borings done by  
Eric Larson from  
Septic Check Inc.  
7/12/2005

(KT) 3-31-16