


320-232-3177

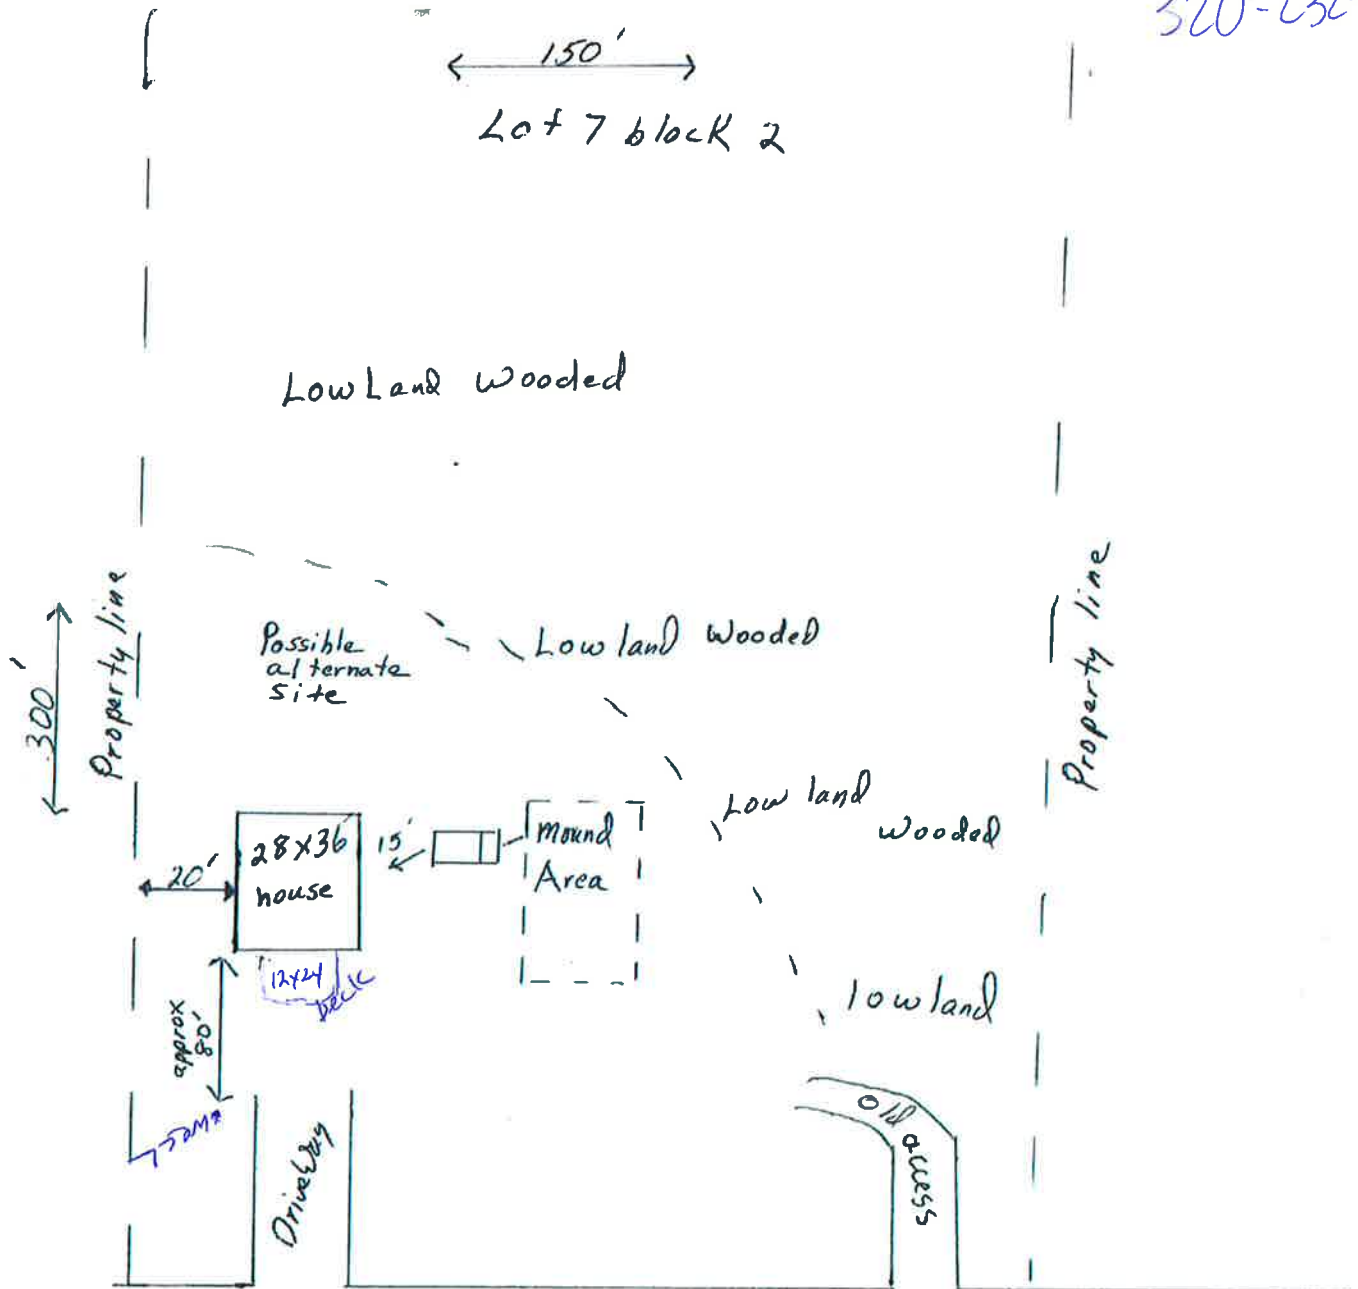

KT 5-26-16