


1" = 40'

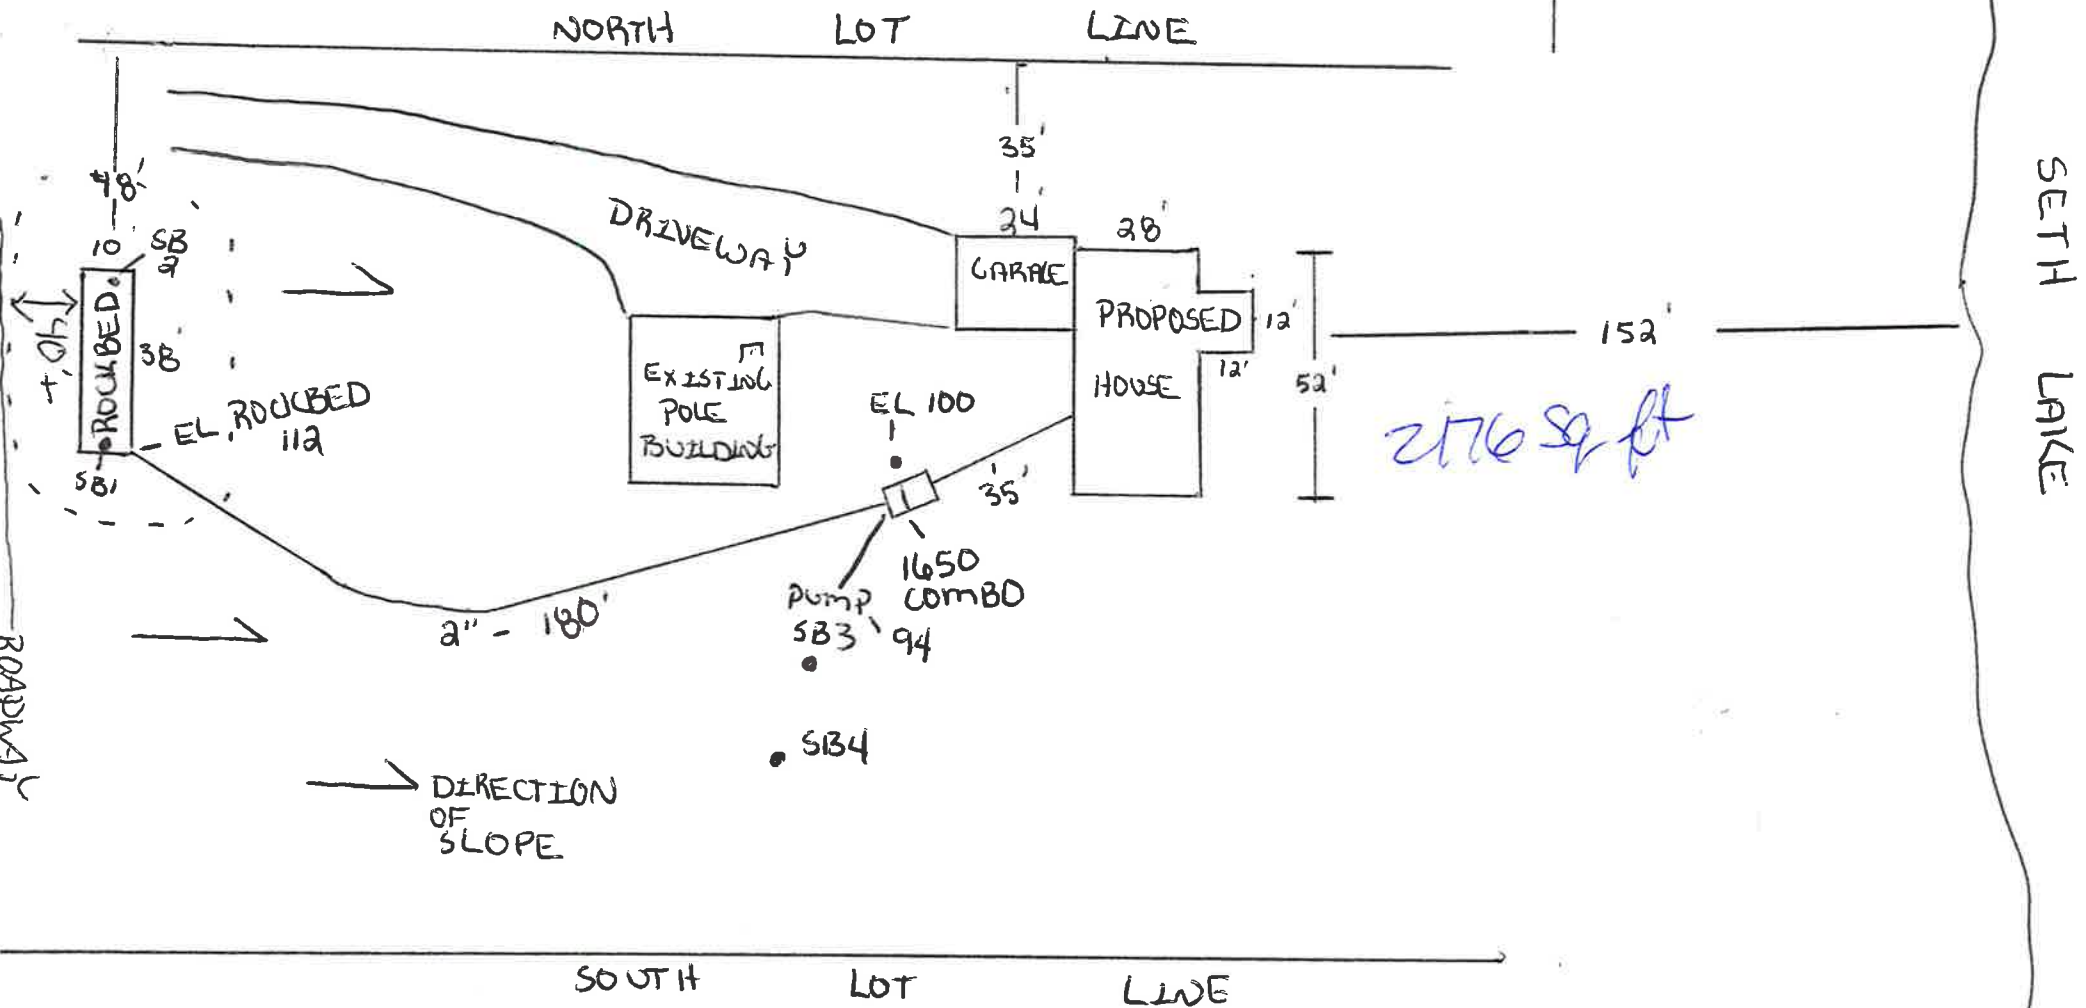

SETH LAKE