


Garage

W.C.

W.C.

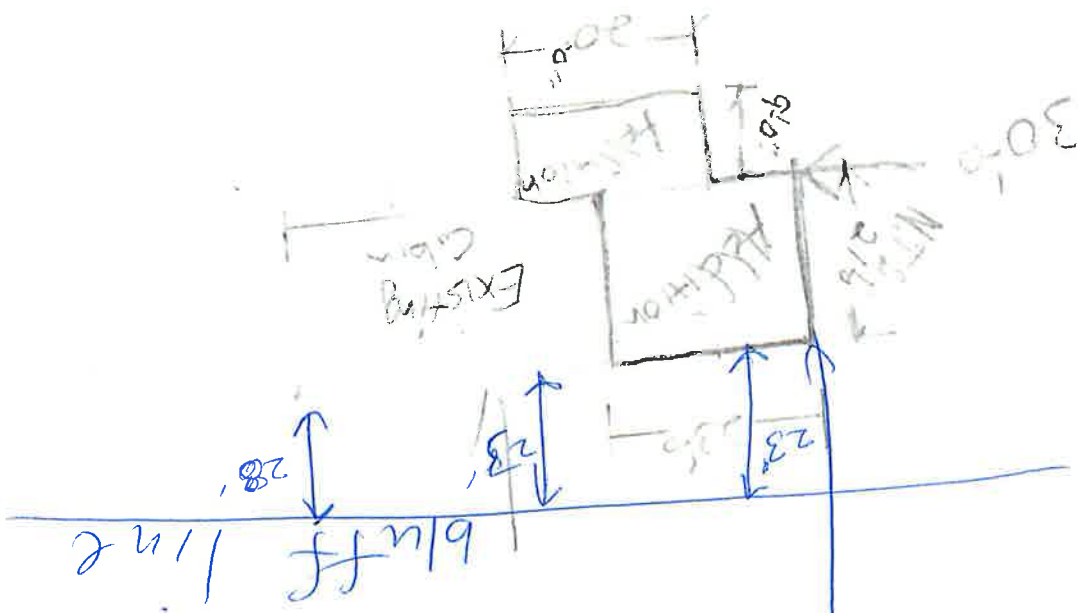

+ 200'

approx  
150 feet  
G.L.S.

Glacier Lake