


AITKIN COUNTY BUILDING PERMIT SITE PLAN

Please indicate the location of: Wells, well setback to system components, buildings, septic system components, reserved septic system area, property lines, waterways, and buried lines. Include size, length, and appropriate distances from fixed reference points. Provide a North directional arrow!

* Per 6/14/16 phone call
meeting all setbacks
(prop lines, septic etc)
will be located north
of the house.

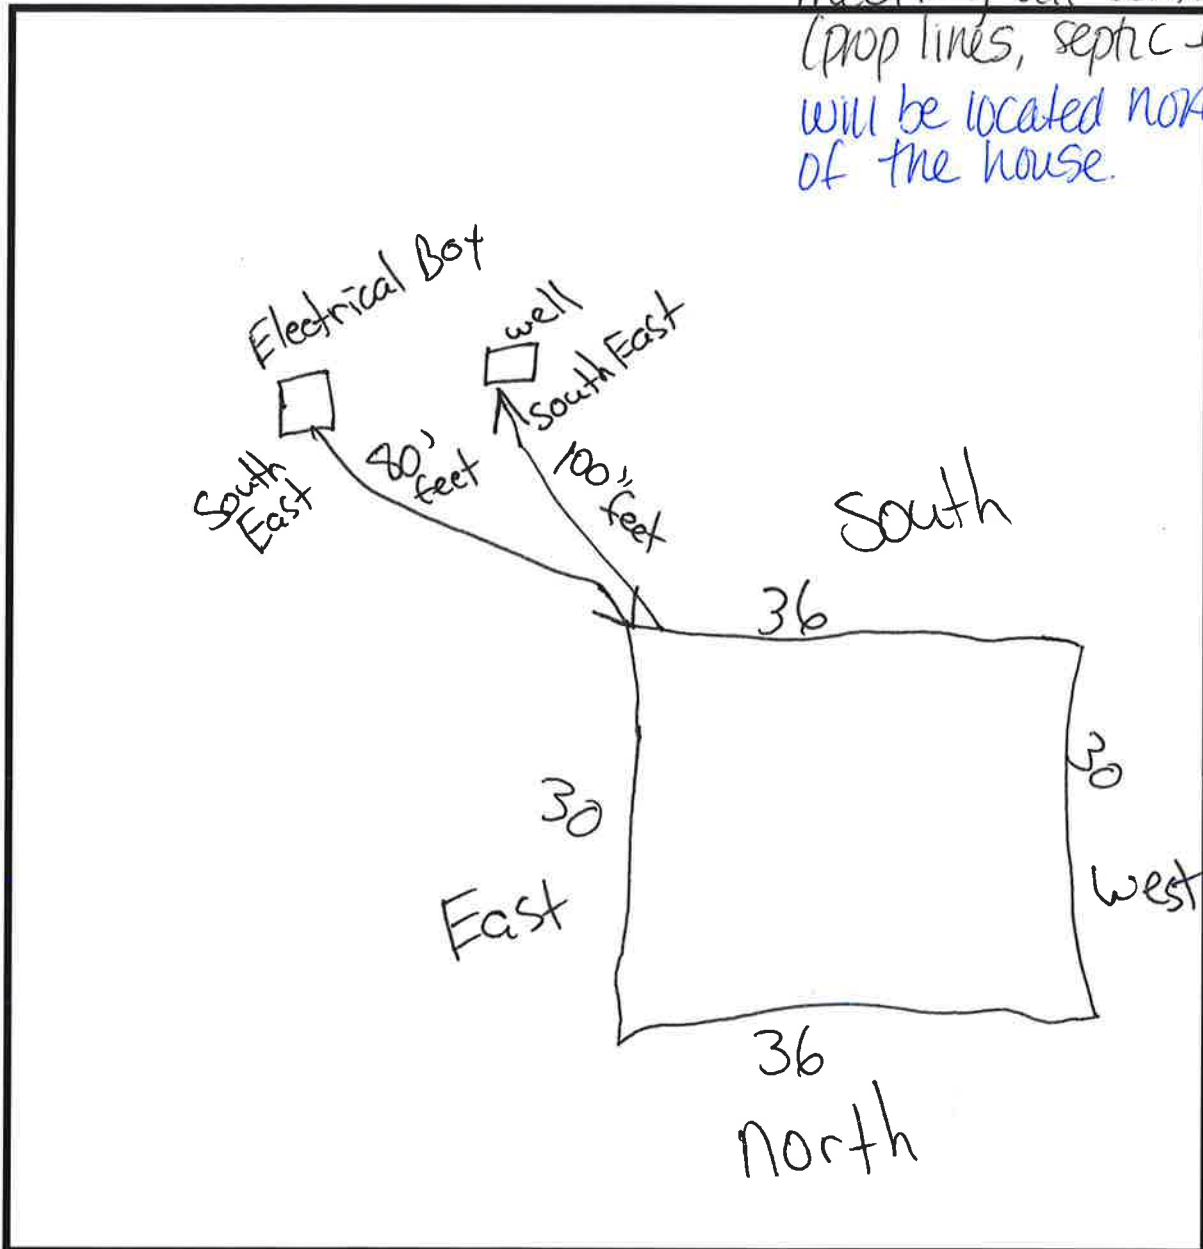

ZONING PERMIT APPLICATION

FULL NAME Daniel Swan Sama TELE # 651-587-7736
 MAIL ADDRESS 12398 100th St.
 CITY Sandstone, STATE Mn ZIP 55072
 911 ADDRESS OF PROPERTY 12398 100th St.
 CITY Sandstone STATE Mn ZIP 55072
 TOWNSHIP Wagner
 LEGAL DESCRIPTION _____
 SECTION 34 TOWNSHIP Wagner RANGE _____

OFFICE USE ONLY	
DATE _____	APPROVE / DENY _____
PERMIT# _____	
PARCEL# <u>34-0-056900</u>	
RECEIPT# _____	
CHECK # _____	
CONFORMING SEPTIC	
YES CI: _____	NO _____ NEW _____

(circle) RESIDENTIAL COMMERCIAL ACCESSORY NEW BUILDING ALTERATION
 BUILDING CONTRACTOR AND LICENSE NUMBER: myself for build

DESCRIBE YOUR PROJECT (IF APPLICABLE, INCLUDE DIMENSIONS OF ALL BUILDINGS COVERED BY THIS APPLICATION)
30w x 36 garage 10w x 7H garage door Slab on grad
2x6 Framing. Tore Down old Shed replacing it with a
new one same spot, same size. plywood sheeting on walls +
Roof bought material At memosols, ~~blue~~ Blueprint designed by them.
 COMMENTS: Electrical contractor to come in + bury new cable + do all
out lets.

DESIGNER: _____
 DATA FOR SEWER CONSTRUCTION: INSTALLER N/A #BEDROOMS/GPD N/A

The undersigned hereby makes application for permit to construct as herein specified, agreeing to do all such work in strict accordance with the Ordinances of the County of Aitkin, Minnesota; Minnesota Individual Sewage Disposal Code Minimum Standards set forth by Minnesota Department of Health; and Shoreland Management Standards set forth by Minnesota Department of Natural Resources. Applicant agrees that plot plan, sketches and specifications submitted herewith and which are approved by the Zoning Official, shall become a part of the permit. **APPLICANT FURTHER AGREES THAT NO PART OF THE SEWAGE SYSTEM SHALL BE COVERED UNTIL IT HAS BEEN INSPECTED AND ACCEPTED.** It shall be the responsibility of the applicant for the permit to notify the Zoning Office (at least 24 hours in advance) that the Septic System is ready for inspection.

[Signature]
 SIGNATURE APPLICANT/AGENT

-----DO NOT WRITE BELOW THIS LINE-----

ZONING DISTRICT & FLOOD PLAIN
 ZONING DISTRICT FR
 LAKE/STREAM/RIVER NAME _____
 LAKE/RIVER ID NUMBER _____
 LAKE/RIVER/STREAM CLASSIF. _____
 PARCEL LOCATED IN FLOOD PLAIN? Y ___ N ___
 10/100-YR. FLOOD ELEVATION _____
 LOWEST FLOOR ELEVATION _____
 ELEV. CERTIFICATE REQUIRED Y ___ N ___
 BEFORE CONSTRUCTION Y ___ N ___
 AFTER CONSTRUCTION Y ___ N ___

STRUCTURE SETBACK DISTANCE REQUIREMENTS
 (Measure from eaves or overhang)
 OHW TO LAKE/RIVER/STREAM _____
 PROPERTY LINE SETBACK (10-ft. / 20-ft.) _____
 SETBACK TO ROAD R-O-W (30-ft. Twp. / 50-ft. Co., State, Fed.) _____
 SETBACK TO BLUFF (30-ft.) _____
SEPTIC SYSTEM SETBACK DISTANCES
 SETBACK TO STRUCTURES (10-ft. Tank / 20-ft. Drainfield) _____
 OHW TO LAKE/RIVER _____
 PROPERTY LINE SETBACK (10-ft.) _____
 SETBACK TO ROAD R-O-W (10-ft.) _____

****ATTACH COPY OF ELEVATION CERTIFICATES****

SOIL BORINGS _____ SEPTIC DESIGN _____ GARBAGE DISP/HOT TUB
 SSF _____ DEPTH TO RESTRICTING LAYER _____ YES ___ NO ___
 (circle) SSTS Type Type 1 Type 2 Type 3 Type 4 Type 5

RECOMMENDATIONS: _____

EXPIRES IN ONE YEAR • Aitkin County Zoning

Courthouse - 209 2nd St. NW. Room 100 • Aitkin, Minnesota 56431 \$ _____

Telephone 218/927-7342 FEE RECEIVED BY DATE
 WHITE - COUNTY YELLOW - APPLICANT PINK - TOWNSHIP

Supplemental Data for Land Use Permits

A. PRE-EVALUATION INSPECTION REQUEST: Defining and staking the property lines, road right-of-ways, septic sites, and wells are the responsibility of the property owner. In some cases, a registered survey may be required to verify setbacks before granting a permit.

B. Directions to your Property From Aitkin:

From a major intersection: Hwy 65 south to Hwy 18 East to
 County Road 20

C. PLANNING CHECKLIST (required for all permits):

- | | YES | NO | ??? |
|---|-------------------------------------|-------------------------------------|--------------------------|
| 1. Are you aware of setback requirements and will your project meet them? (Note: Setback distances are taken from <u>any projection of the building (i.e. overhangs, eaves, decks, etc.)</u>) | <input checked="" type="checkbox"/> | <input type="checkbox"/> | <input type="checkbox"/> |
| 2. Have you taken into consideration locations for future buildings, septic systems, decks, driveways, etc?..... | <input checked="" type="checkbox"/> | <input type="checkbox"/> | <input type="checkbox"/> |
| 3. Will this structure be used for commercial purposes. | <input type="checkbox"/> | <input checked="" type="checkbox"/> | <input type="checkbox"/> |
| 4. Is your property in a floodplain? (If yes, complete Section D).....
<i>If it is, the lowest floor (which includes basement or crawl space, regardless of a dirt floor) must be one foot (1') above the 100-year flood elevation or 3 feet above the highest known water level. A benchmark established by a registered surveyor or licensed engineer may be required before granting a land use permit.</i> | <input type="checkbox"/> | <input checked="" type="checkbox"/> | <input type="checkbox"/> |
| 5. Are there any lowlands or wetlands on or near the site project? | <input type="checkbox"/> | <input checked="" type="checkbox"/> | <input type="checkbox"/> |
| 6. Will your project meet the impervious surface requirements? | <input checked="" type="checkbox"/> | <input type="checkbox"/> | <input type="checkbox"/> |
| <i>Note: In the Shoreland District, structures cannot exceed 15% of lot area and total impervious surfaces cannot exceed 25% of lot area. Lot area must not include wetland or bluff areas or land below the ordinary high water level. Non-shoreland areas have a maximum of 35% total impervious surface.</i> | | | |

ALL PROPOSED DEVELOPMENT REQUESTS MUST BE CLEARLY STAKED AT ALL FOUR CORNERS. PROPERTY LINES MUST BE FLAGGED NEAR THE PROPOSED CONSTRUCTION. IF STAKES ARE NOT PRESENT OR VISIBLE IT MAY RESULT IN ADDITIONAL FEES AND/OR A DELAY IN THE PERMIT PROCESS. The undersigned hereby makes application for a pre-evaluation permit inspection, agreeing that all setback information and delineation of property lines, well location, road setbacks, and development corners have been properly identified and marked.

Telephone Number between the hours of 8:00 A.M. and 4:00 P.M. 651-587-7736

LANDOWNER SIGNATURE: X [Signature]

Shoreland Zoning includes any property within 1,000 feet of a lake, 300 feet of any other river, stream or flowage or the landward extent its floodplain , or within 500 feet of the Mississippi River.

**NON SHORELAND PROPERTIES STOP HERE
 SHORELAND PROPERTIES COMPLETE PAGE 2**

SHORELAND PROPERTIES CONTINUED

- | | YES | NO | ??? |
|---|-------------------------------------|-------------------------------------|--------------------------|
| 7. Will your project be less than the maximum structure height allowed in shoreland (35 feet, as measured from the lowest adjoining ground level to the highest point of the roof)? | <input checked="" type="checkbox"/> | <input type="checkbox"/> | <input type="checkbox"/> |
| 8. Is there a steep slope or bluff on or near the site? | <input type="checkbox"/> | <input checked="" type="checkbox"/> | <input type="checkbox"/> |
| 9. Are you constructing a walkout basement in the shoreland district of a lake, river, or stream (If yes, please provide plan) | <input type="checkbox"/> | <input checked="" type="checkbox"/> | <input type="checkbox"/> |
| 10. Will there be any activity (vegetation removal or earth moving) in the Shore Impact Zone, Bluff Impact Zone or on a steep slope of a lake or river? (If yes, please provide plan) | <input type="checkbox"/> | <input checked="" type="checkbox"/> | <input type="checkbox"/> |
| 11. If you are building an accessory structure, please provide sidewall height and if there will be a loft or second story. (No living quarters, sleeping areas, baths, showers or toilet facilities are allowed in accessory structures.) <u>no loft or second story</u> | | | |

D. NATURAL LANDSCAPE PROTECTION PLAN:

To ensure that earth moving and vegetation removal is within ordinance guidelines, and to ensure activity on your property does not negatively impact the lake or other properties, you may be required to provide additional drawings of your site plan.

12. Setback from the Ordinary High Water Level (OHW) for proposed construction? _____
13. How many cubic yards of fill or excavation will be done on the property? 80 yards sand for concrete
14. How close to the property line will any fill be placed or any excavation be done? no fill or excavation
15. If you are constructing a walkout basement, please identify on the drawing where the excavated material will be placed.
16. What percent slope of the land currently exists on the construction site? NA
(If the percent slope is greater than 18%, supply copy of Site review from SWCD)
17. How will erosion be controlled during construction? (Attach additional info and drawings as necessary)
- _____
- _____
18. What will be done after construction to control erosion? Back fill around building to slope water away. Turn into yard
- _____
- _____

I have read the above and I understand the Natural Landscape Protection Plan as prepared. I hereby agree to implement this plan as part of the Land Use Permit.

[Signature] 6-10-16 _____ _____
 Landowner Signature Date Zoning Official Date