



Porta John / out house

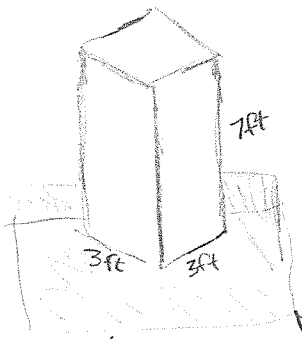

holding tank

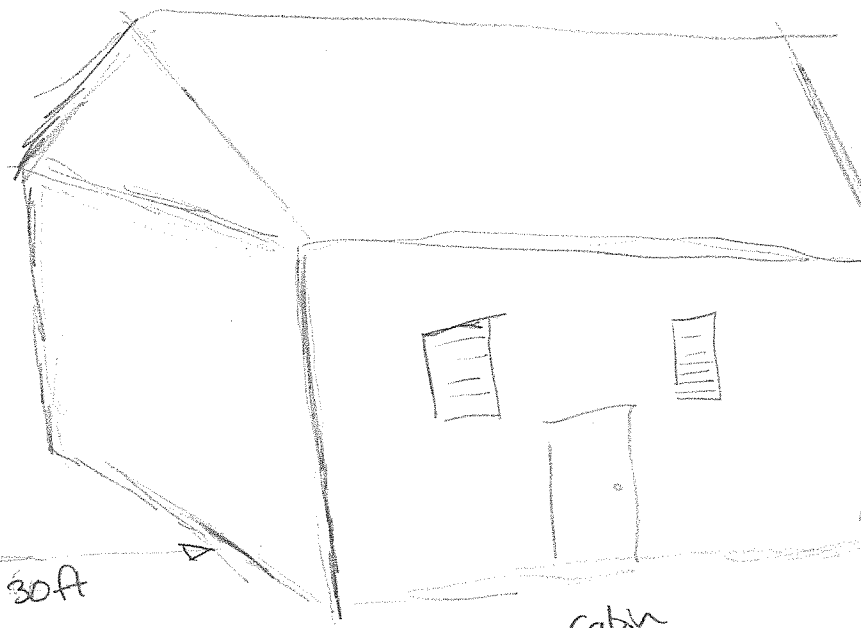

Cabin

20-30ft

40-50ft

Well pit

