

144th Ln

X Well

S

800'

675'


59 kmH  
Hwy 65

N

390'

new  
36 x 48

E

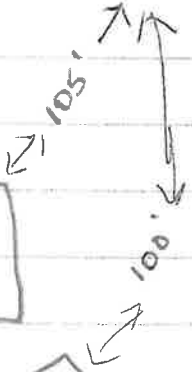

N