



SKETCH AND DESCRIPTION

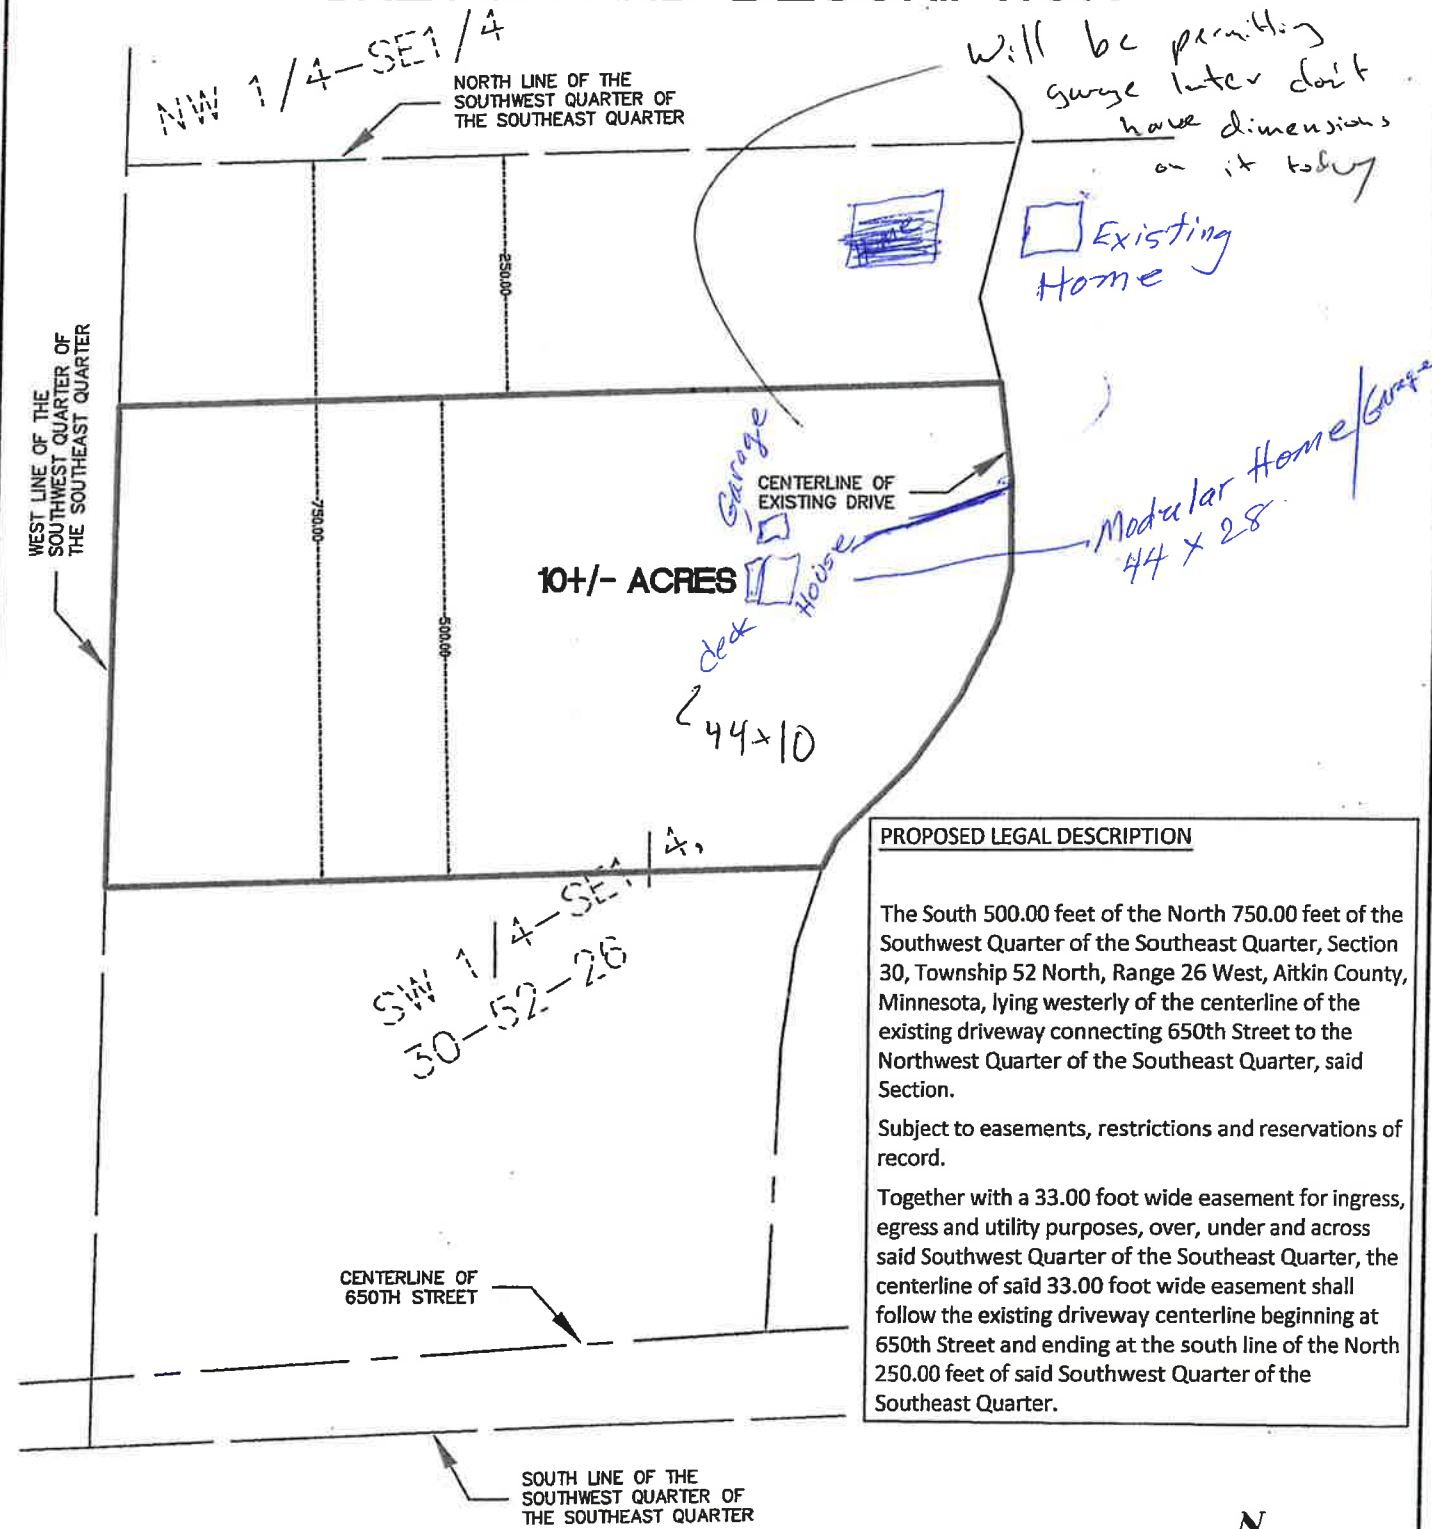

INFORMATION SHOWN ON THIS SKETCH AND DESCRIPTION IS A COMPILATION OF VARIOUS SURVEY INFORMATION. NO FIELD WORK WAS DONE TO VERIFY ANY INFORMATION SHOWN HEREON.

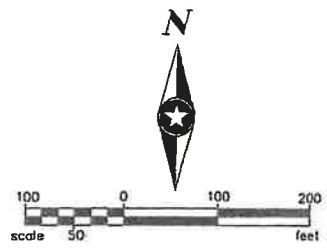

P:\AE\BATH\137691\5-final-dsgn\51-drawings\10-civil\cad\civil_3d\BA137691 exhibit.dwg 6/14/2016 8:35 AM dwarnr

I HEREBY CERTIFY THAT THIS PLAN WAS PREPARED BY ME OR UNDER MY DIRECT SUPERVISION AND THAT I AM A DULY LICENSED LAND SURVEYOR UNDER THE LAWS OF THE STATE OF MINNESOTA.

Dennis J. Warner Name, R.L.S.
DENNIS J. WARNER
 Date: 6-14-2016 Lic. No. 42656



SKETCH AND DESCRIPTION FOR:
HOWARD BATTEN
SWATARA, MN

REV. 0 DATE:
 PROJ. NO.
BATTH 137691