


Google Maps

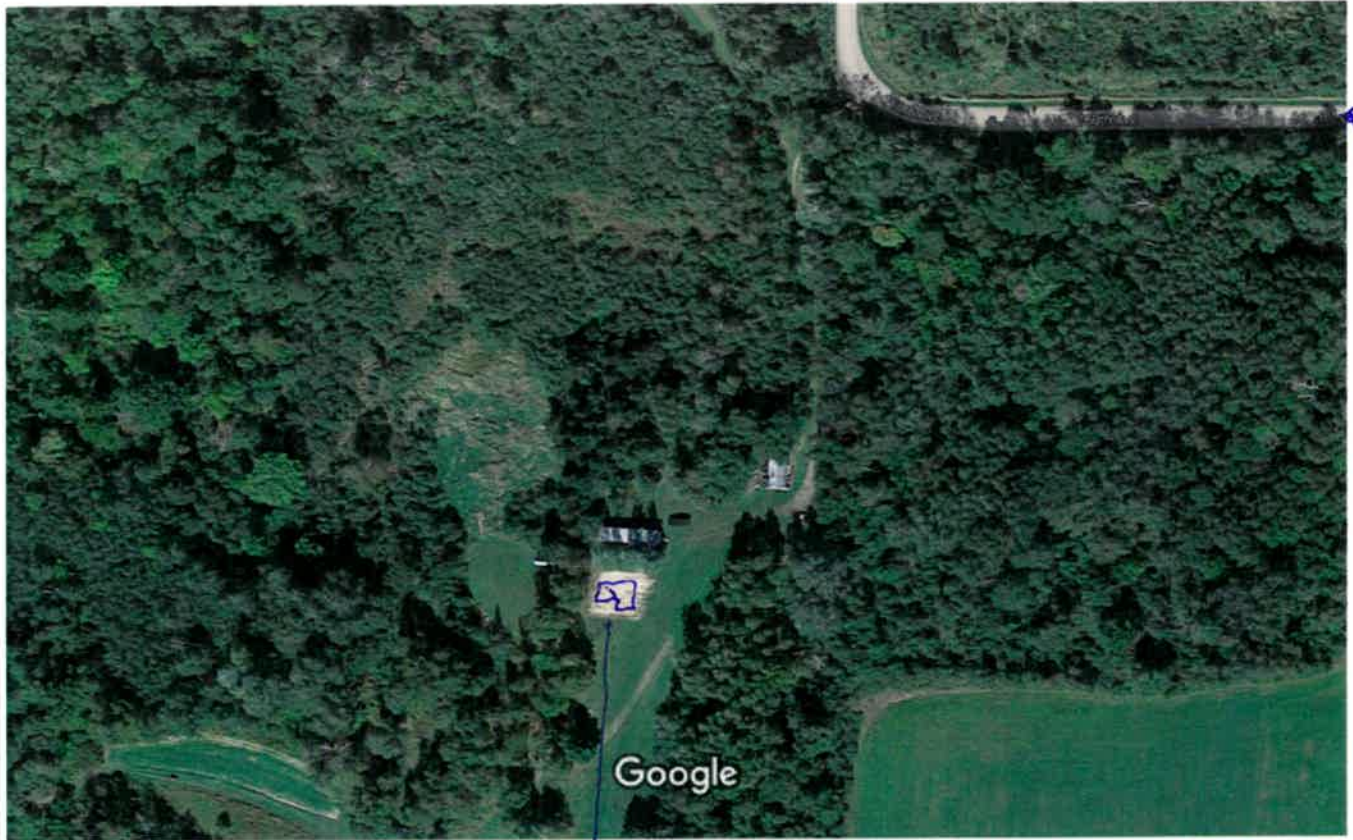

±160'

building site

Imagery ©2016 Google, Map data ©2016 Google 50 ft



- distance to East property line \approx 80 ft
- distance to Road \approx 425 feet
- distance to shed \approx 200 feet
- distance to trailer* \approx 20 ft.

* will be removed when complete