SOIL BORING LOG #1			SOIL BORING LOG #2		
DEPTH	TEXTURE	COLOR	DEPTH	TEXTURE	COLOR
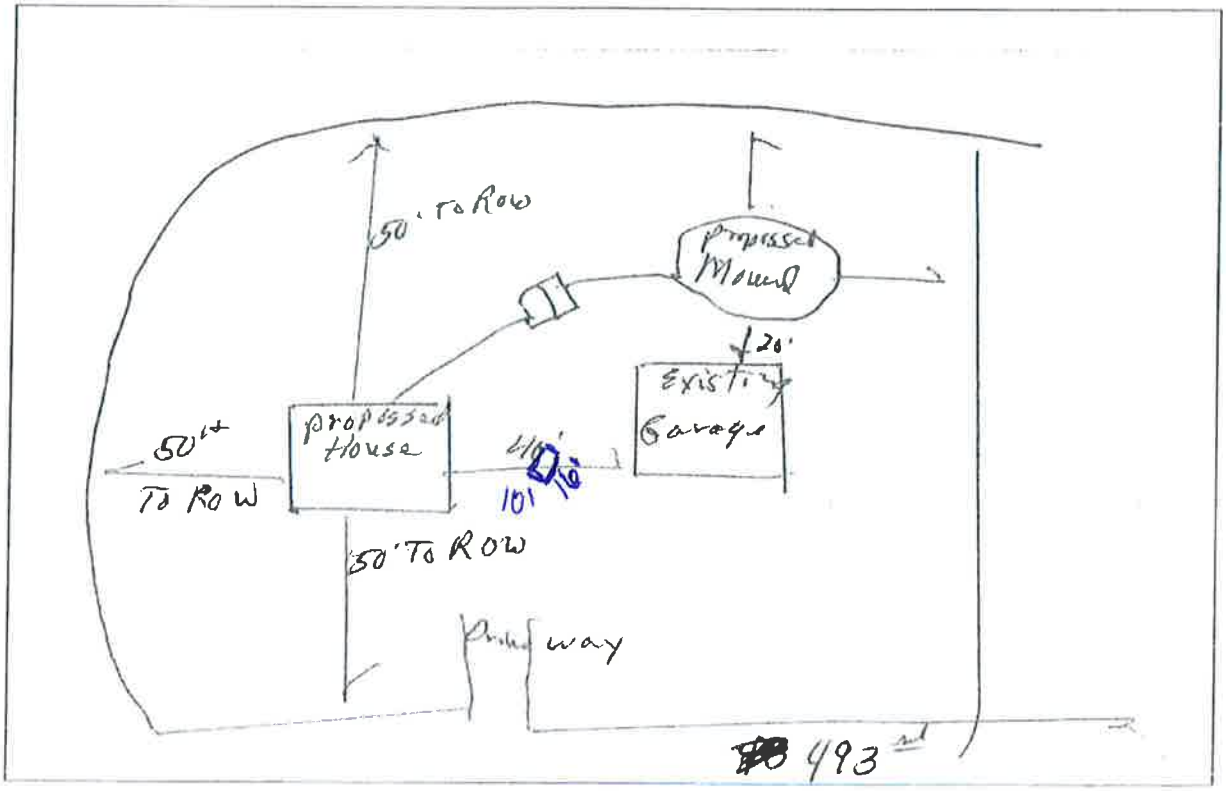
IDENTIFY LOCATIONS OF: (BORINGS, NEIGHBORING STRUCTURES, WELLS, DRAINFIELDS, DRAINAGE PATTERNS, OR OTHER FEATURES THAT MAY IMPACT THE SITE).