


Old Trailer House  
North

Property line locations are not known  
(Old gravel Pit Area)

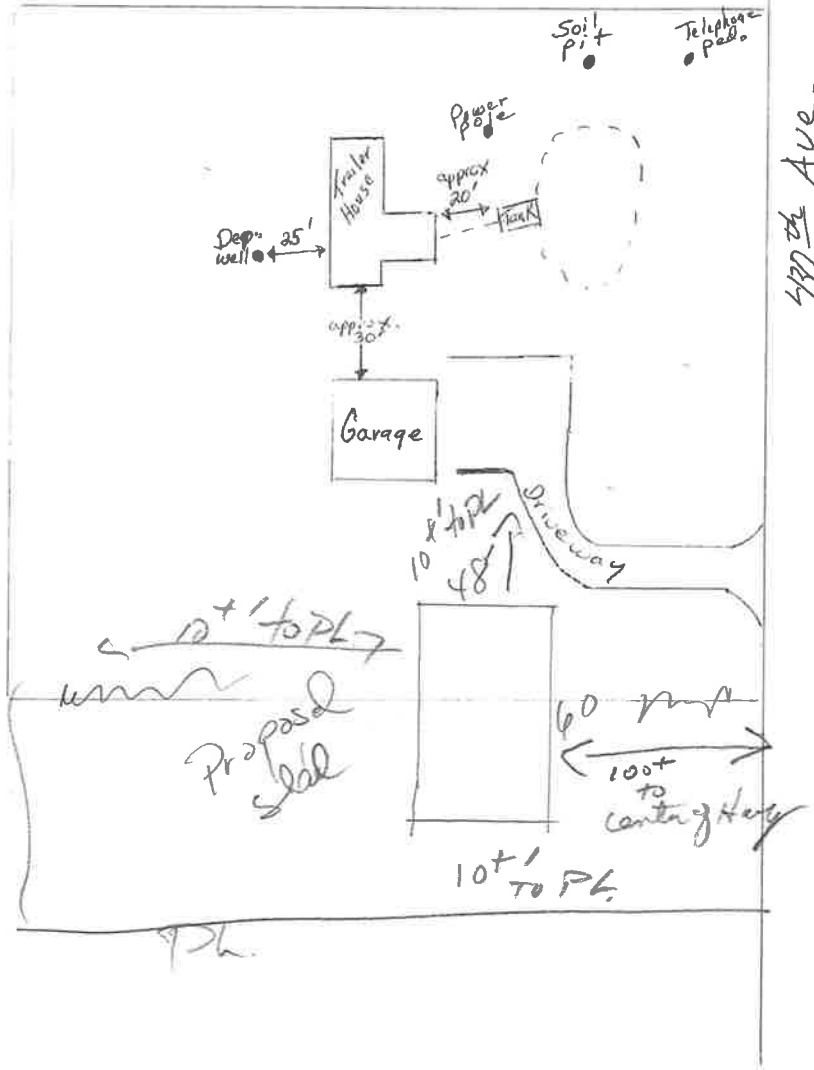

Proposed  
48x60 shed (storage)  
100+ ft from center of Hwy  
+ and over 10' from  
all property lines