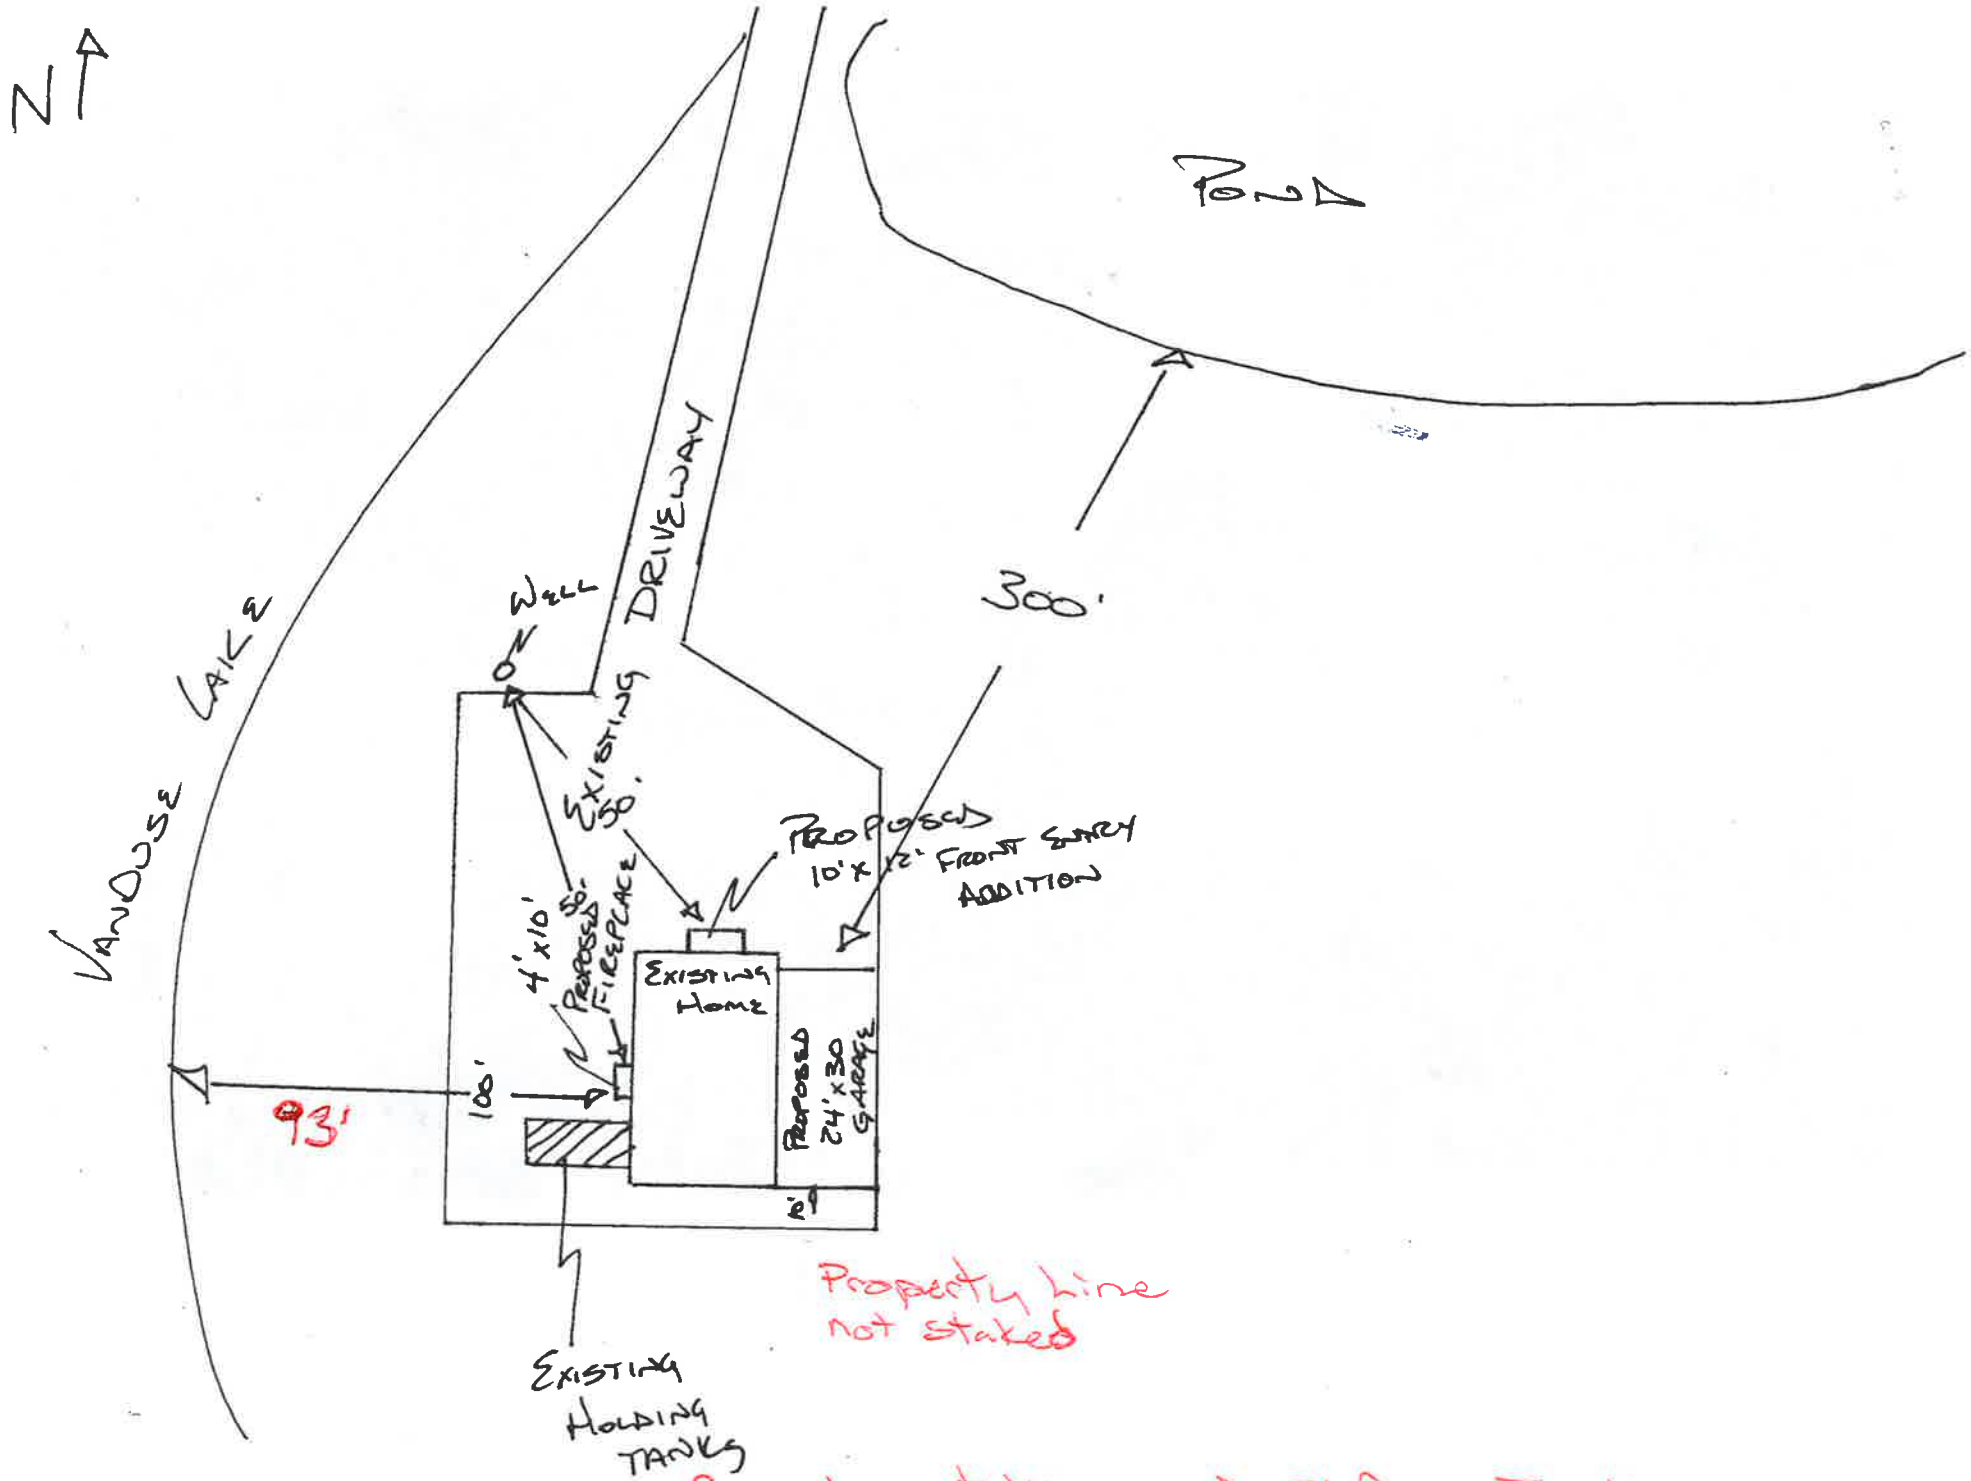
N
Pond
Vandose Lake
Well
Driveway
Existing
50'
300'
Proposed
10' x 12' Front Entry
Addition
4' x 10'
Proposed
Fireplace
50'
Existing
Home
Proposed
24' x 30
Garage
100'
93'
8'
Existing
Holding
Tanks
Property Line
not staked
fireplace staking only 5' from Tanks