


LMC

84'

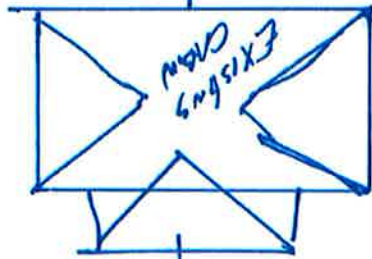


178'

33933  
State Hwy 18

no property  
line of  
shaded



meter  
elec  
11' to

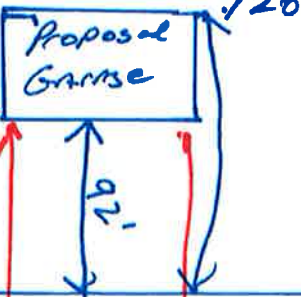

94' to RC  
94' to RC

State Hwy 18