



NOT TO SCALE

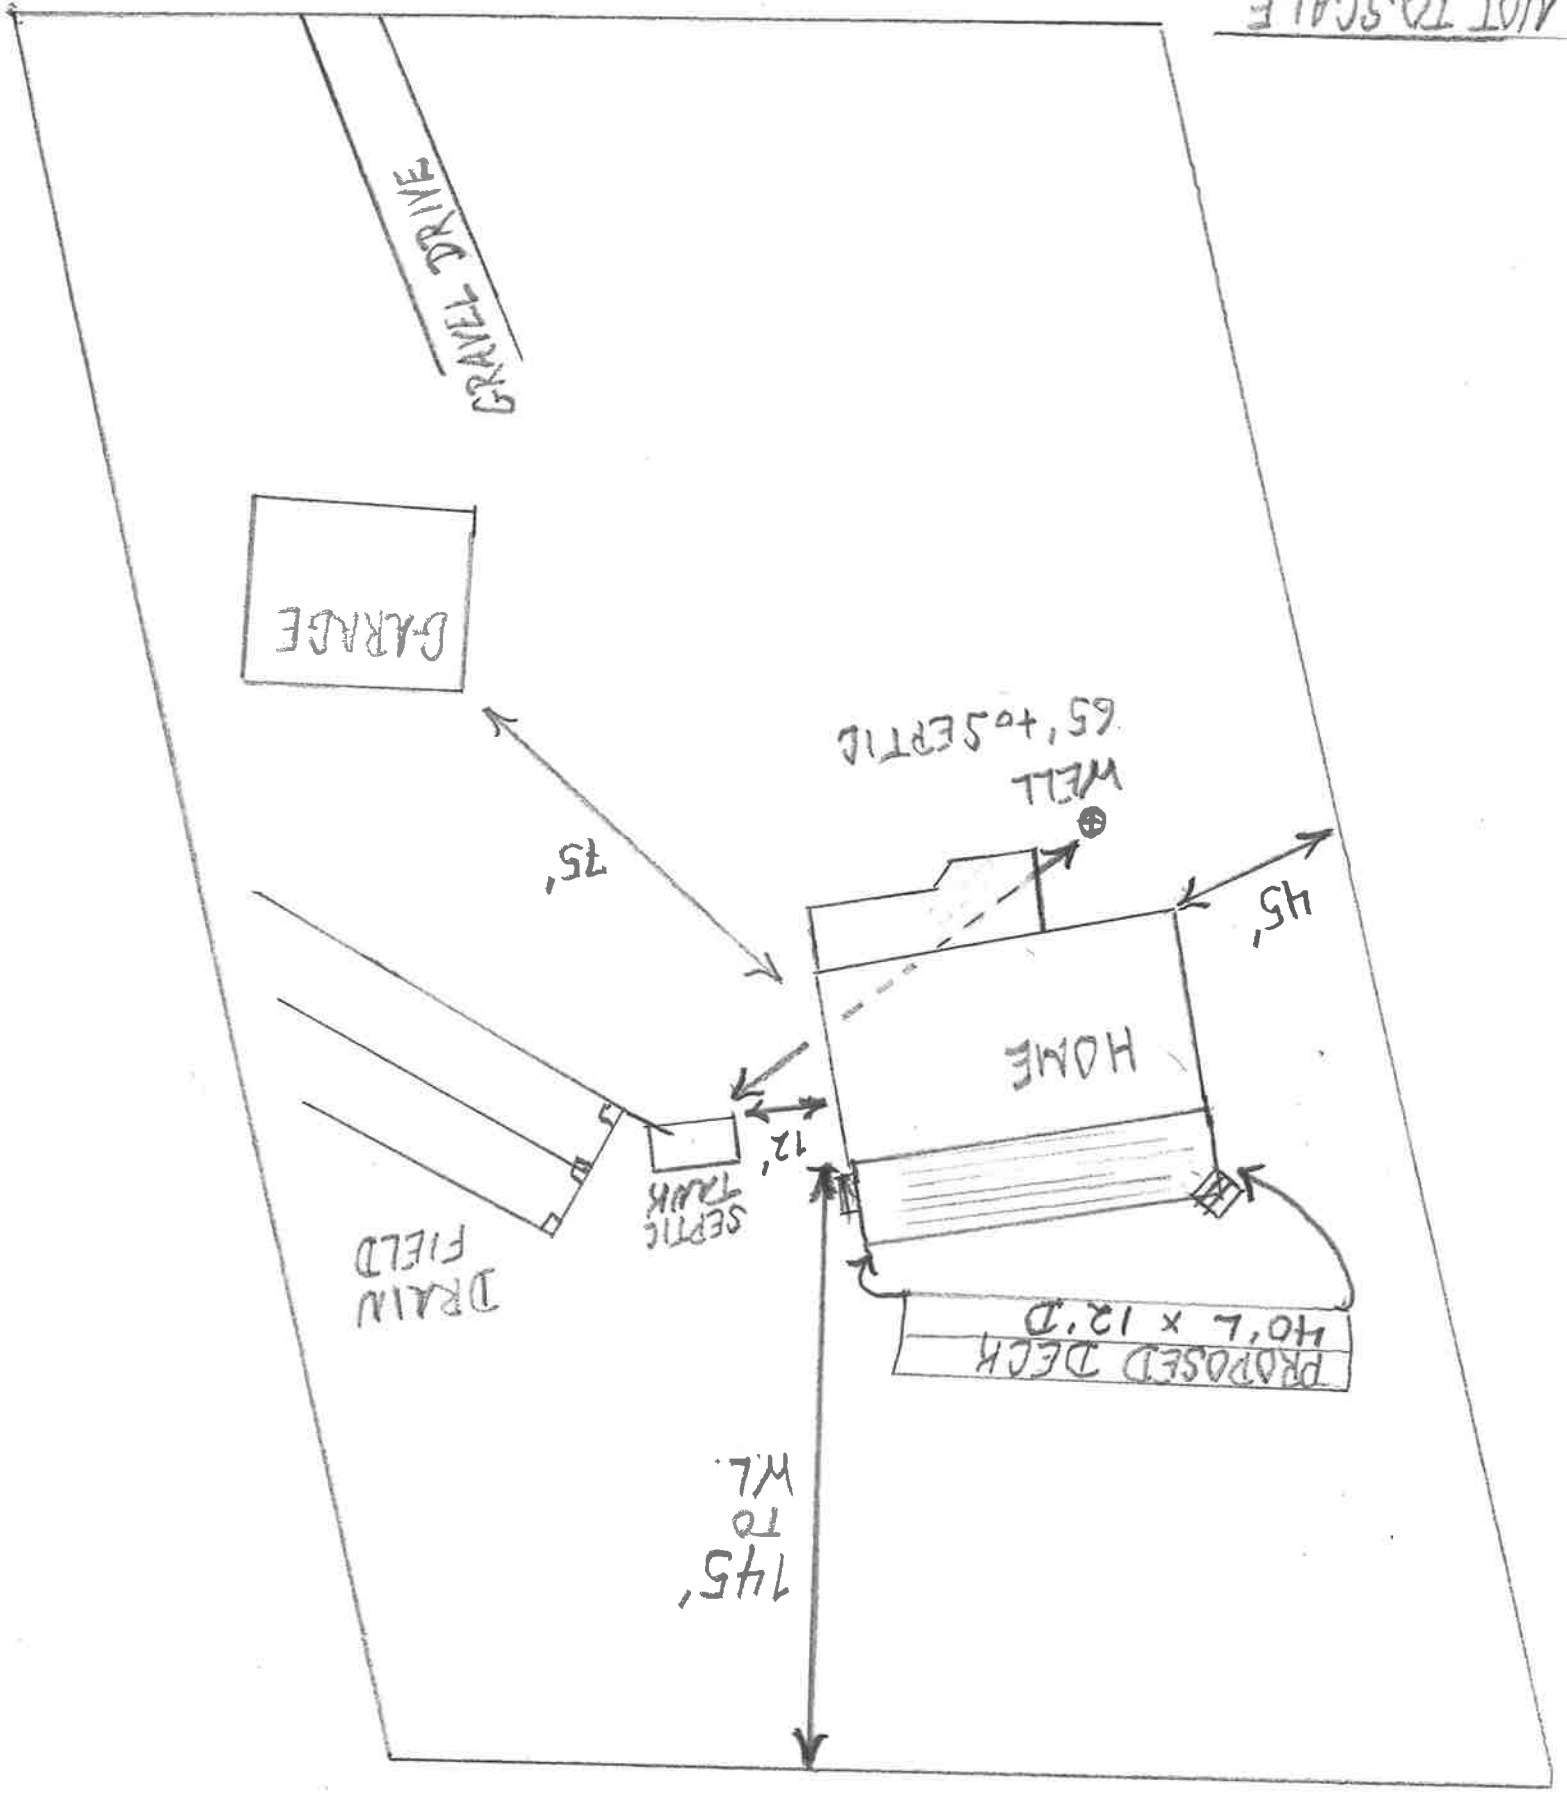

40260 298th LANE

40260 298th LANE

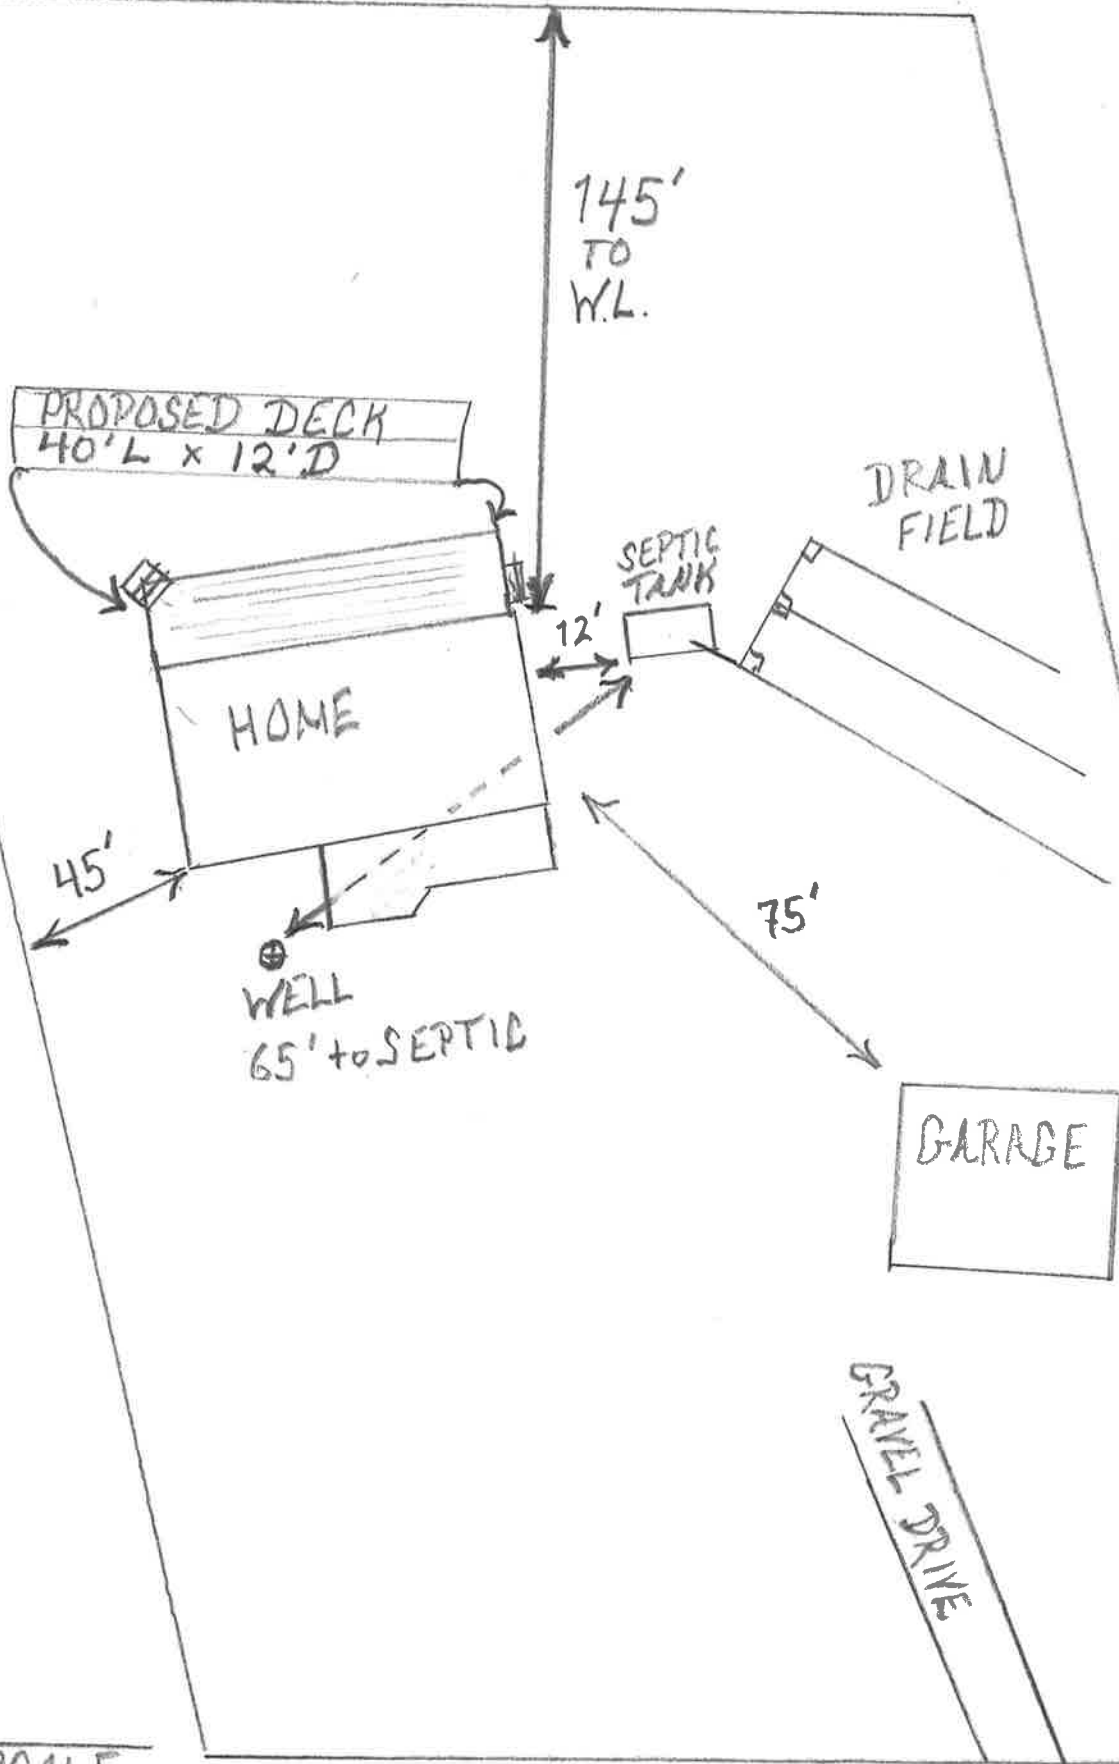

NOT TO SCALE