



← 181' →

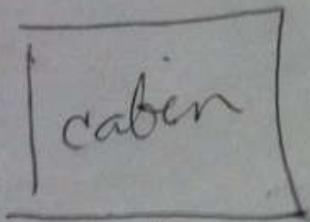

↑  
22'  
↓

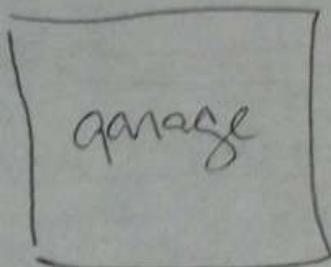

↑  
11'  
↓

North  
→

33'  
↓

511th Ln