


CERTIFICATE OF SURVEY

OF PART OF LOT 3  
SUNSET BEACH  
AITKIN COUNTY, MINNESOTA




16-1-061501

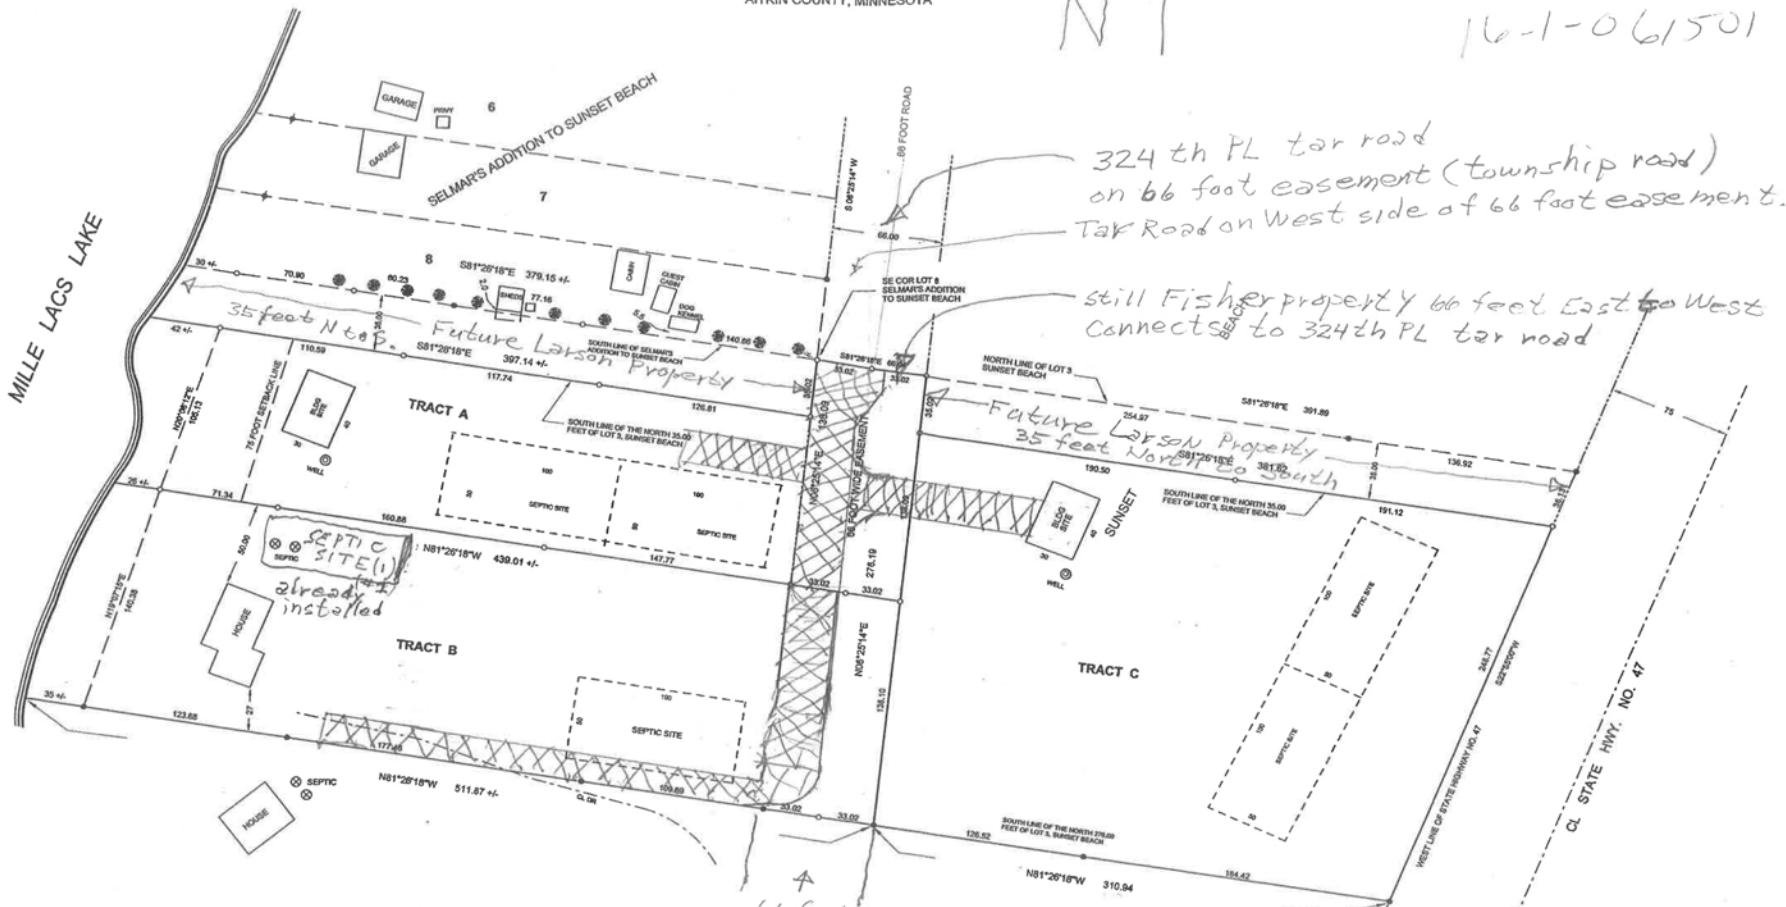

324th PL tar road  
on 66 foot easement (township road)  
Tar Road on West side of 66 foot easement.

still Fisher property 66 feet East to West  
connects to 324th PL tar road

66 foot Easement from South  
Property line to North  
Property line - connects to 66 foot easement off 324th PL N.

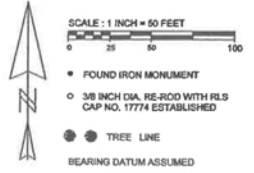

MARVIN KOHOUT  
REGISTERED LAND SURVEYOR  
PO BOX 384  
AITKIN, MN 56431-0384  
1-218-927-5452

I HEREBY CERTIFY THAT THIS SURVEY PLAN OR REPORT WAS  
PREPARED BY ME OR UNDER MY DIRECT SUPERVISION AND  
THAT I AM A DULY REGISTERED LAND SURVEYOR UNDER THE  
LAWS OF THE STATE OF MINNESOTA.

*Marvin R. Kohout*  
DATE 19 JUNE 2013 REG. NO. 17774