

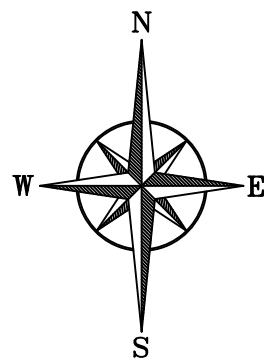


CERTIFICATE OF SURVEY

PART OF LOT 241,
BIG SANDY HIGHLANDS SECOND ADDITION
AITKIN COUNTY, MINNESOTA

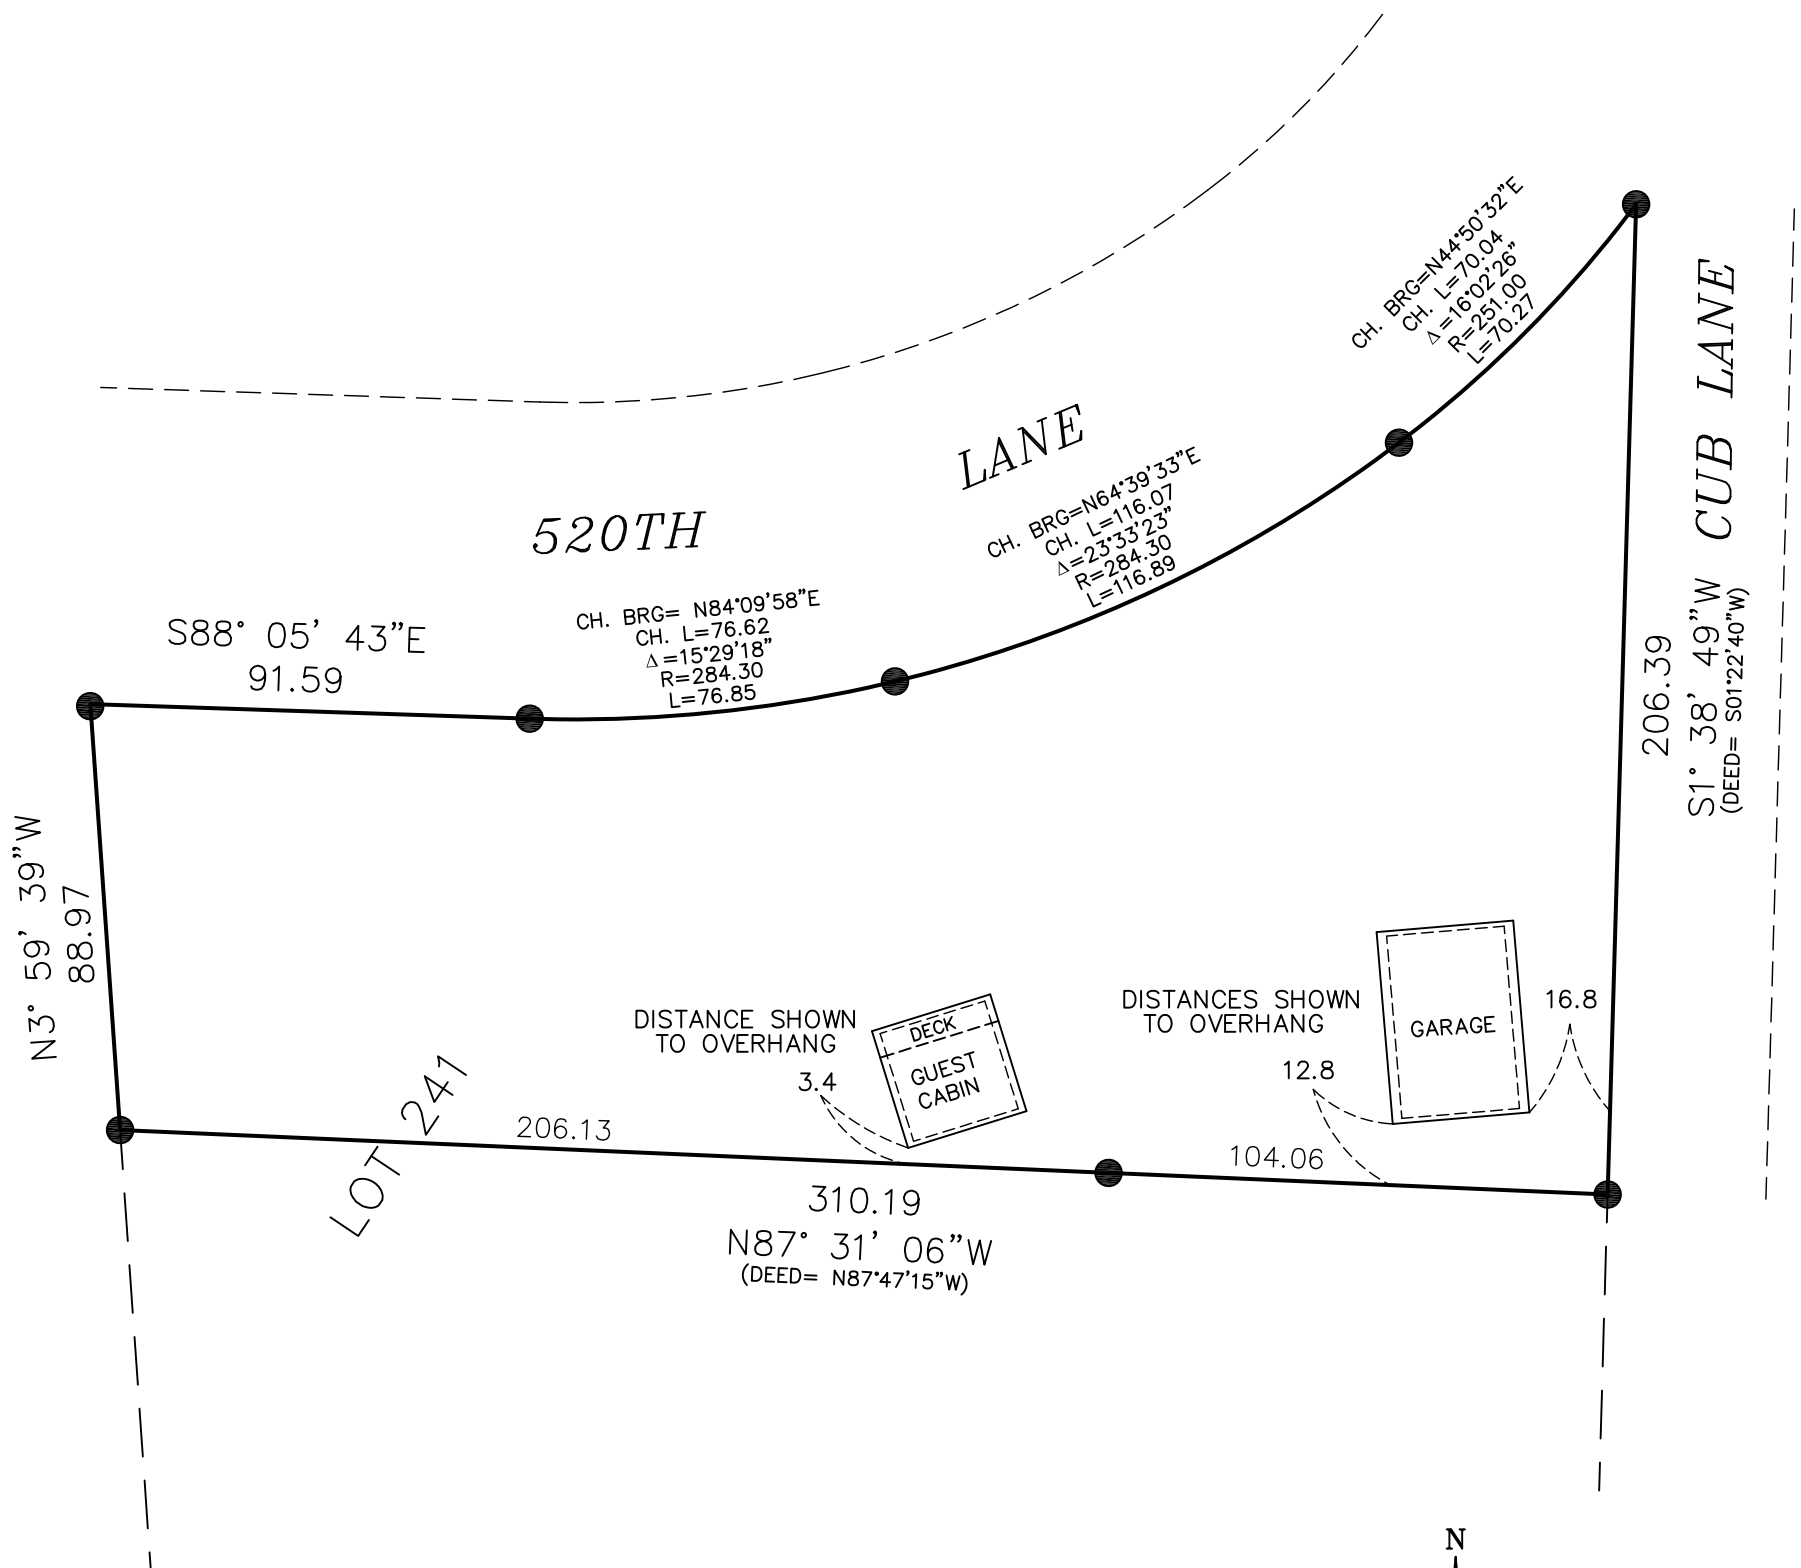

SCALE
1" = 40'

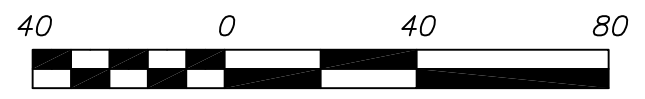

● FOUND 3/8" IRON REBAR W/ RLS CAP 17774

TOTAL LOT AREA= 36,093± SF
GUEST CABIN AREA= 658.4 SF
GARAGE AREA= 1146.5 SF



ZACHARY STATE
PT. OF LOT 241
BIG SANDY HIGHLANDS
SECOND ADDITION
AITKIN COUNTY, MN

JOB#: 18594		DRAWN BY: TJB	
FILENAME: 18594.dwg			
REV#	DESCRIPTION	DATE	

I HEREBY CERTIFY THAT THIS SURVEY, PLAN OR REPORT WAS PREPARED BY ME OR UNDER MY DIRECT SUPERVISION AND THAT I AM A DULY LICENSED LAND SURVEYOR UNDER THE LAWS OF THE STATE OF MINNESOTA.

Michael A. Stang
MICHAEL A. STANG (LIC. NO. 52591)

DATE: 12/04/2018