



116'

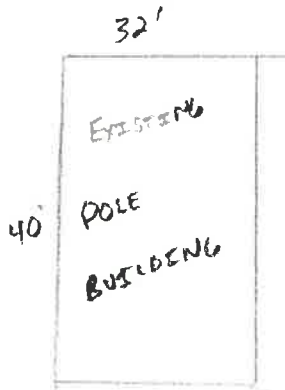

DRIVE WAY

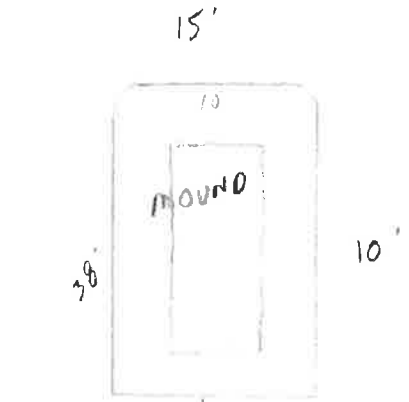

24'



11'
26'8"



200'
Proprietary Stake

30'
NEW Stake

45'

200'

217th

110' LANE

ISLE

65'
new
R.C.