


lake shore

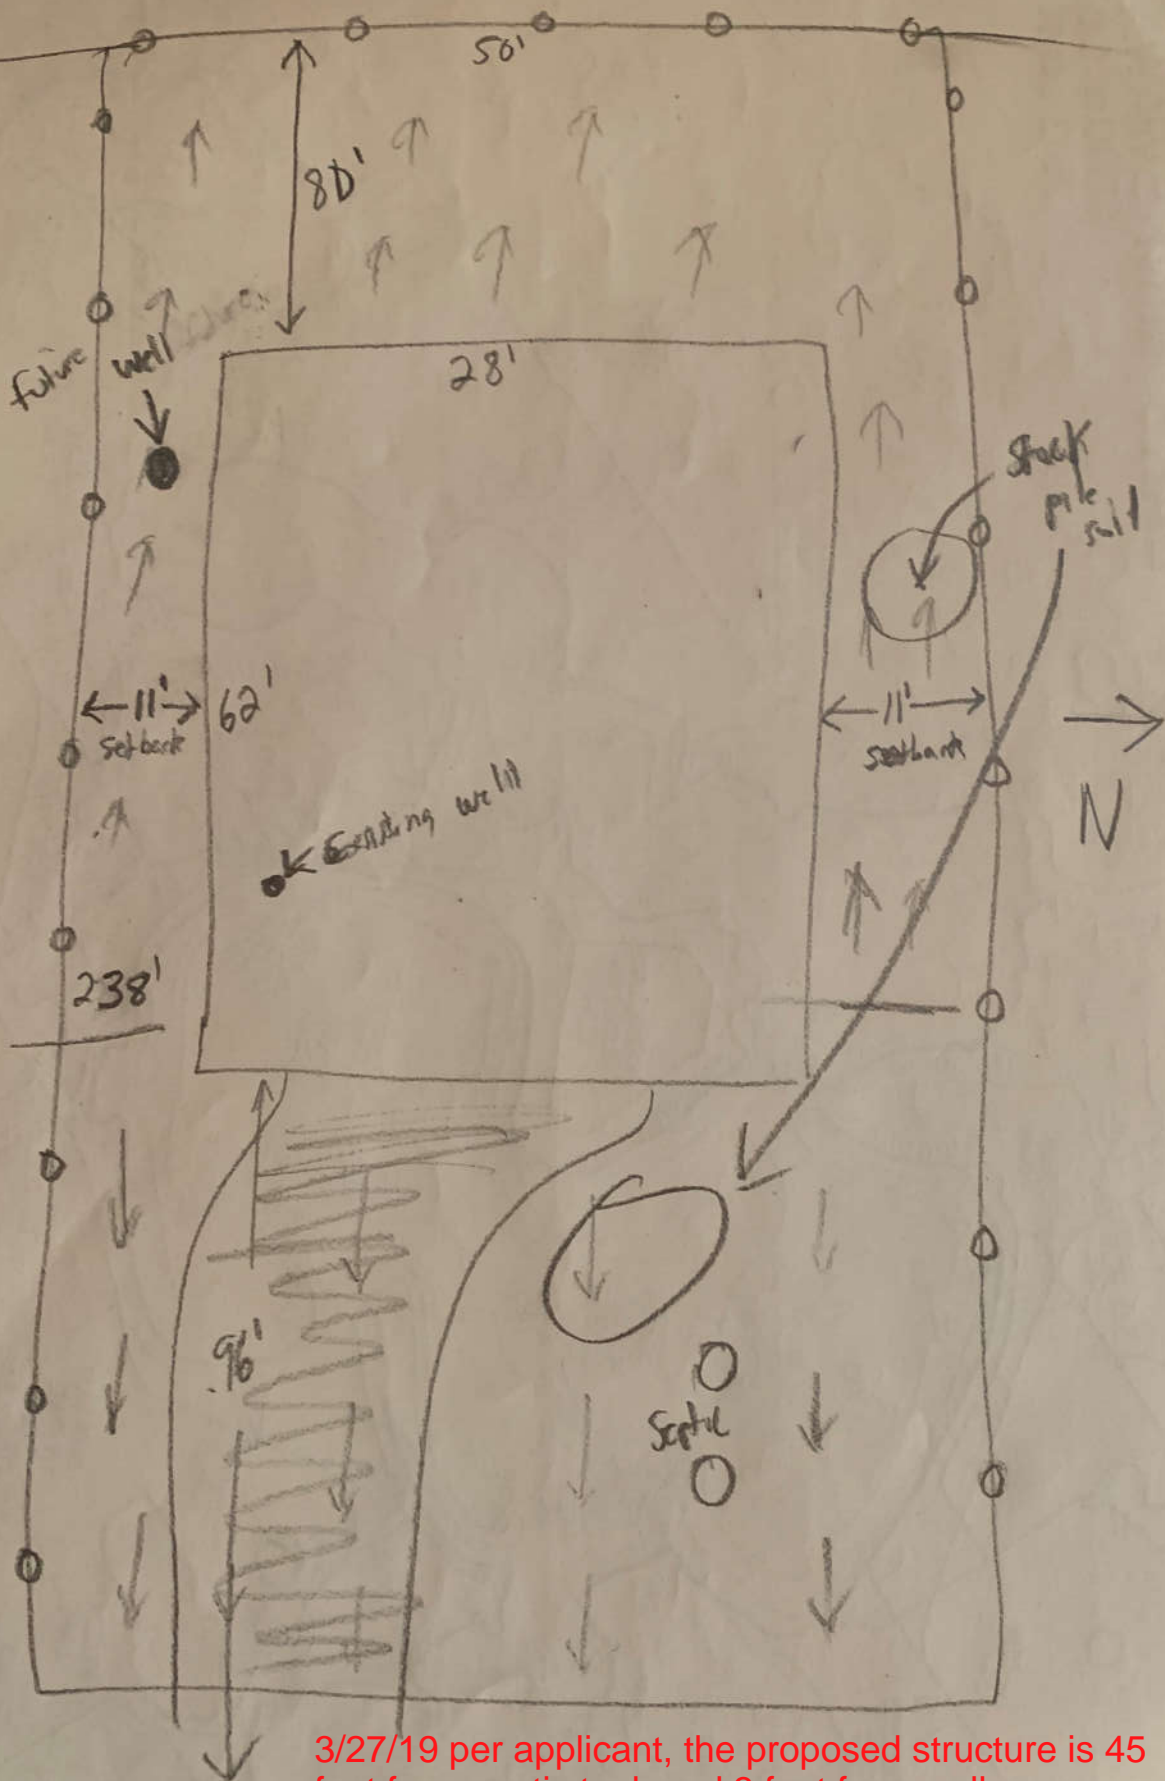

3/27/19 per applicant, the proposed structure is 45 feet from septic tank and 3 feet from well. sw

188th ave