




MANION LUMBER & TRUSS

P.O. Box 67 • Pillager, MN 56473
(218) 746-3200 • 1-800-450-3456
Fax (218) 746-3994

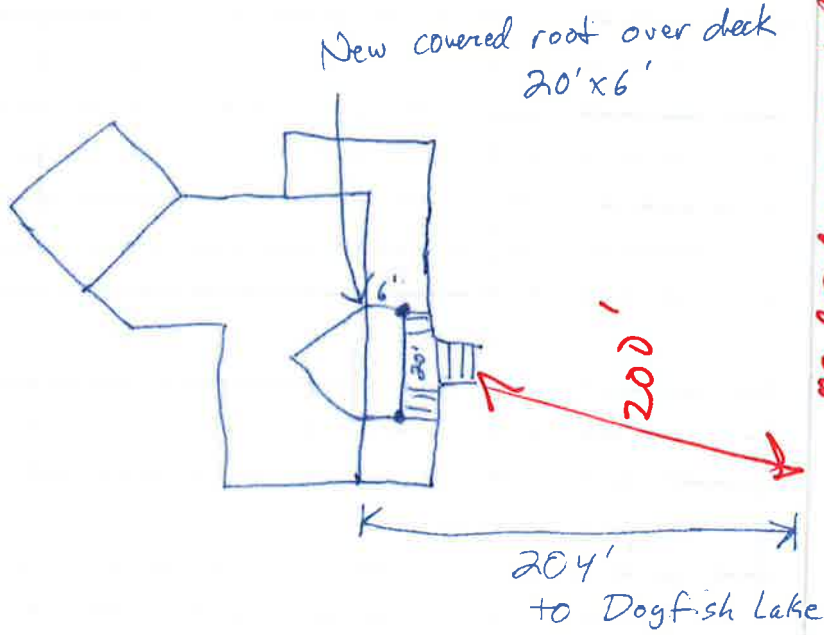

*measured to
base of stairs
because they are
> 4' wide*