



← 600' →

This diagram is the center section of our property



4 Acres

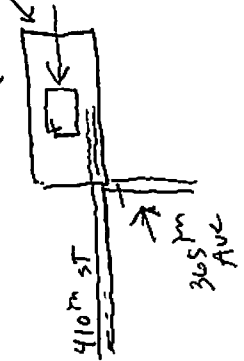

← 300' →

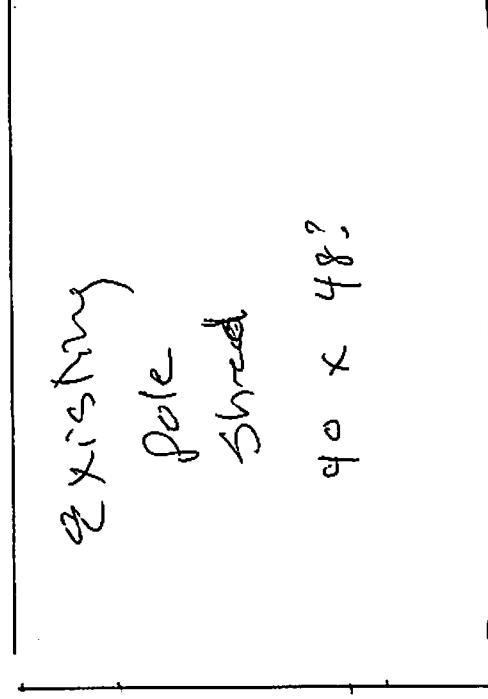

← 30' →

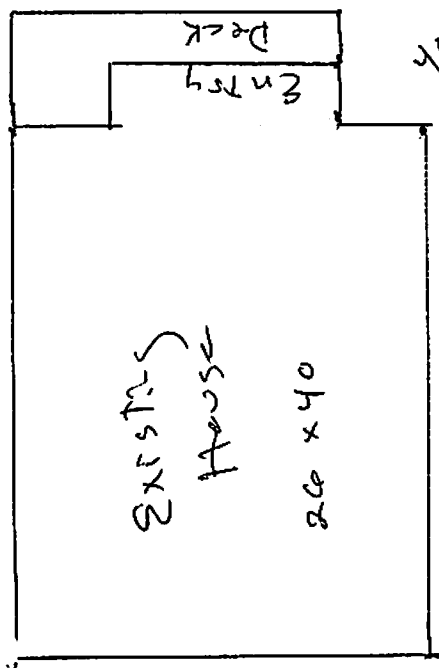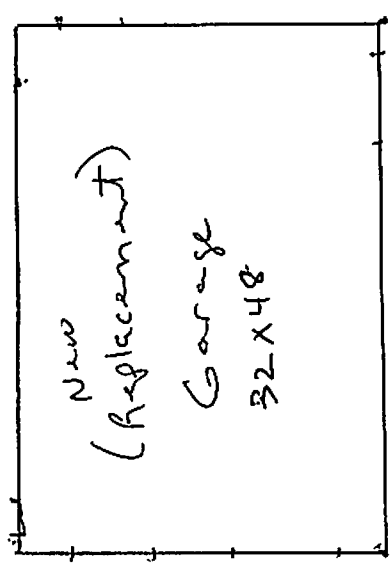

← 10' →

Septic on side of house  
 South East corner  
 40' away from house

← wall NE of house  
 75' →

↑ N ↓

NOT TO SCALE