


39834 PORTAGE LAKE RD.

SITE PLAN SHOWING PROPOSED LOCATION OF NEW  
10' x 20' SHED

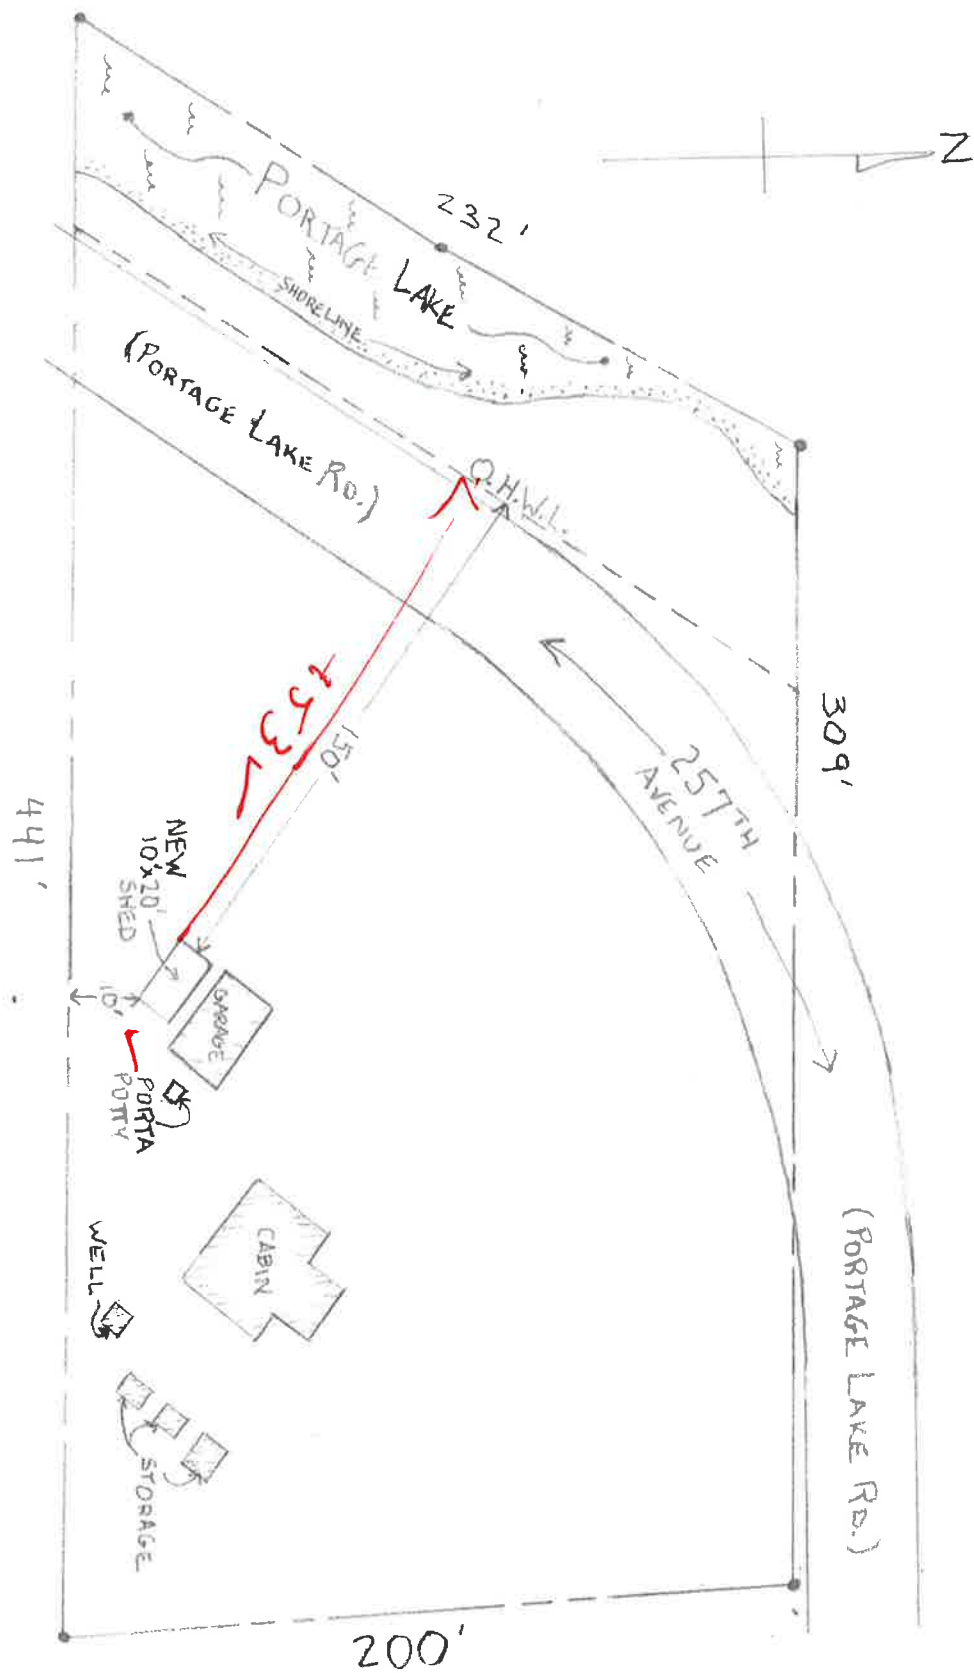

T. Soder. Cook