




Portage Lake

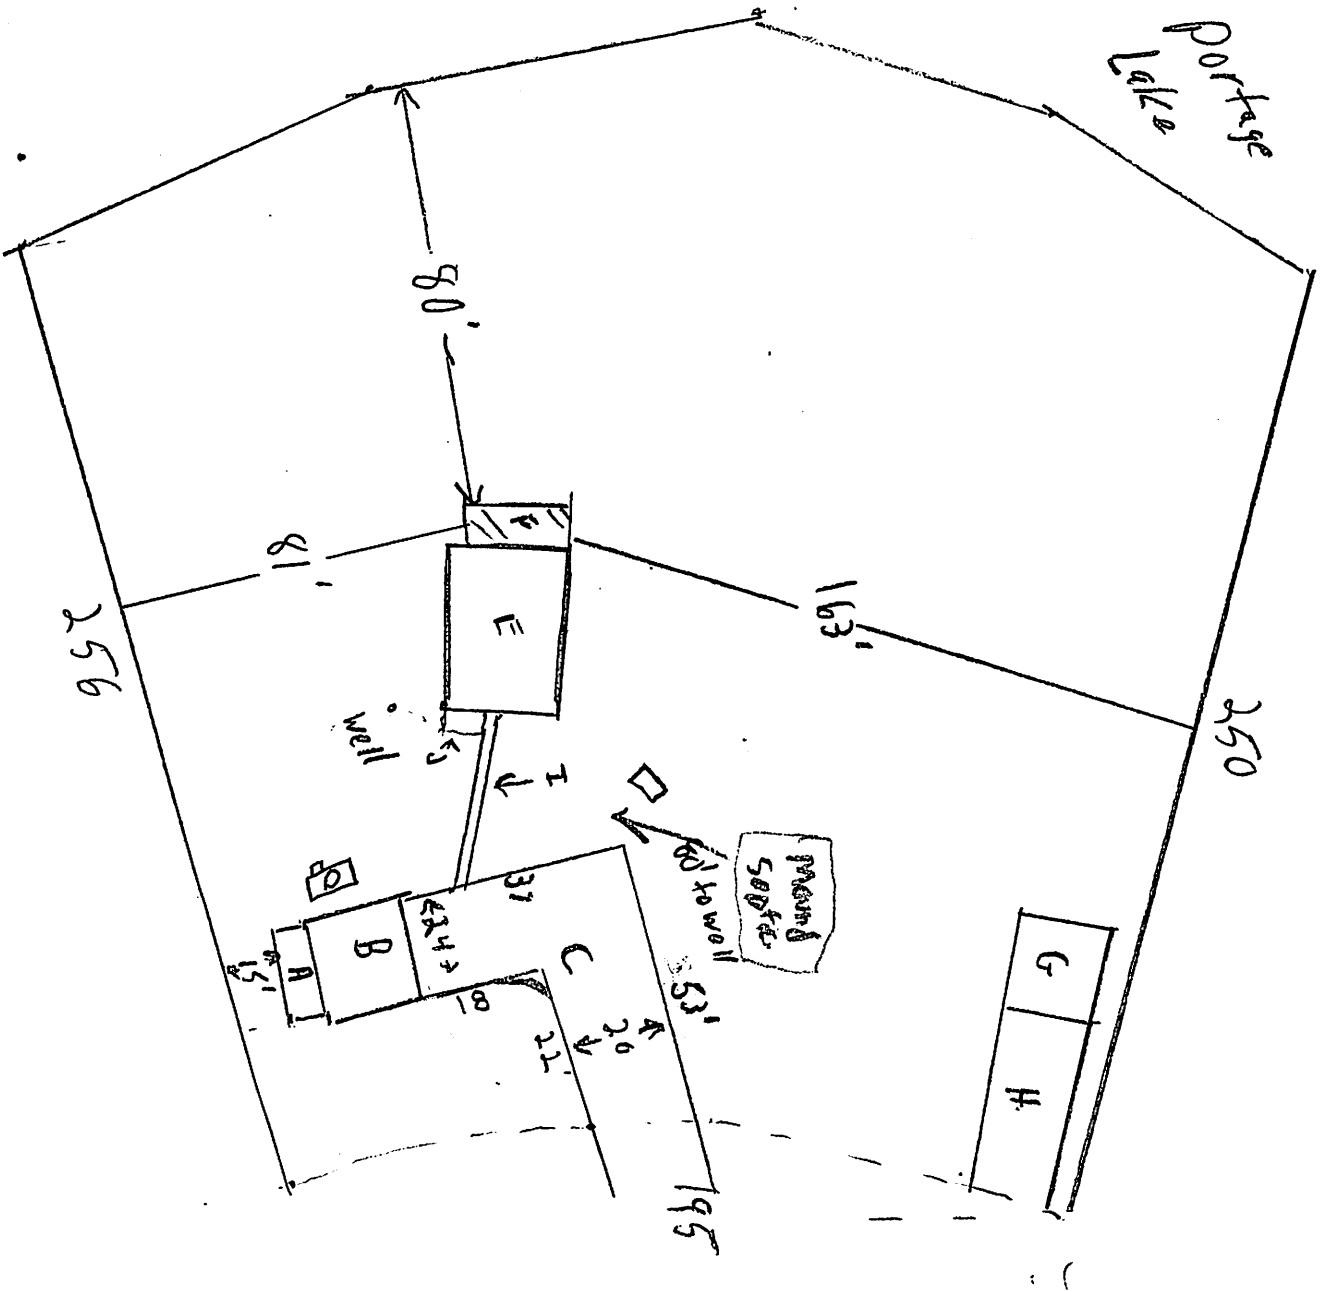

1" = 50'

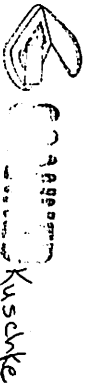

45-1-05490 TWP47 R24 Sec 6 Portage estates lots 11-12-13-14

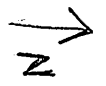

Kuschke 23910 Stoneview Atchison MN

Lot Size 1,7575 Acres or 76,295'

- 2000' A 24x25 lean-to
- 624' B 24x26 Garage
- 1500' C Drive
- 310' D 12x20 Shed + 10x7 pad.
- 1360' E House 34x40
- 384' F 12x32' proposed porch
- 624' G 24x26 Garage
- 1200' H 24x50 Drive
- 250' I 4'x20' side walk
- 755 6x15' pad.
- 6557' or 8,662' Lot coverage.