CERTIFICATE OF SURVEY
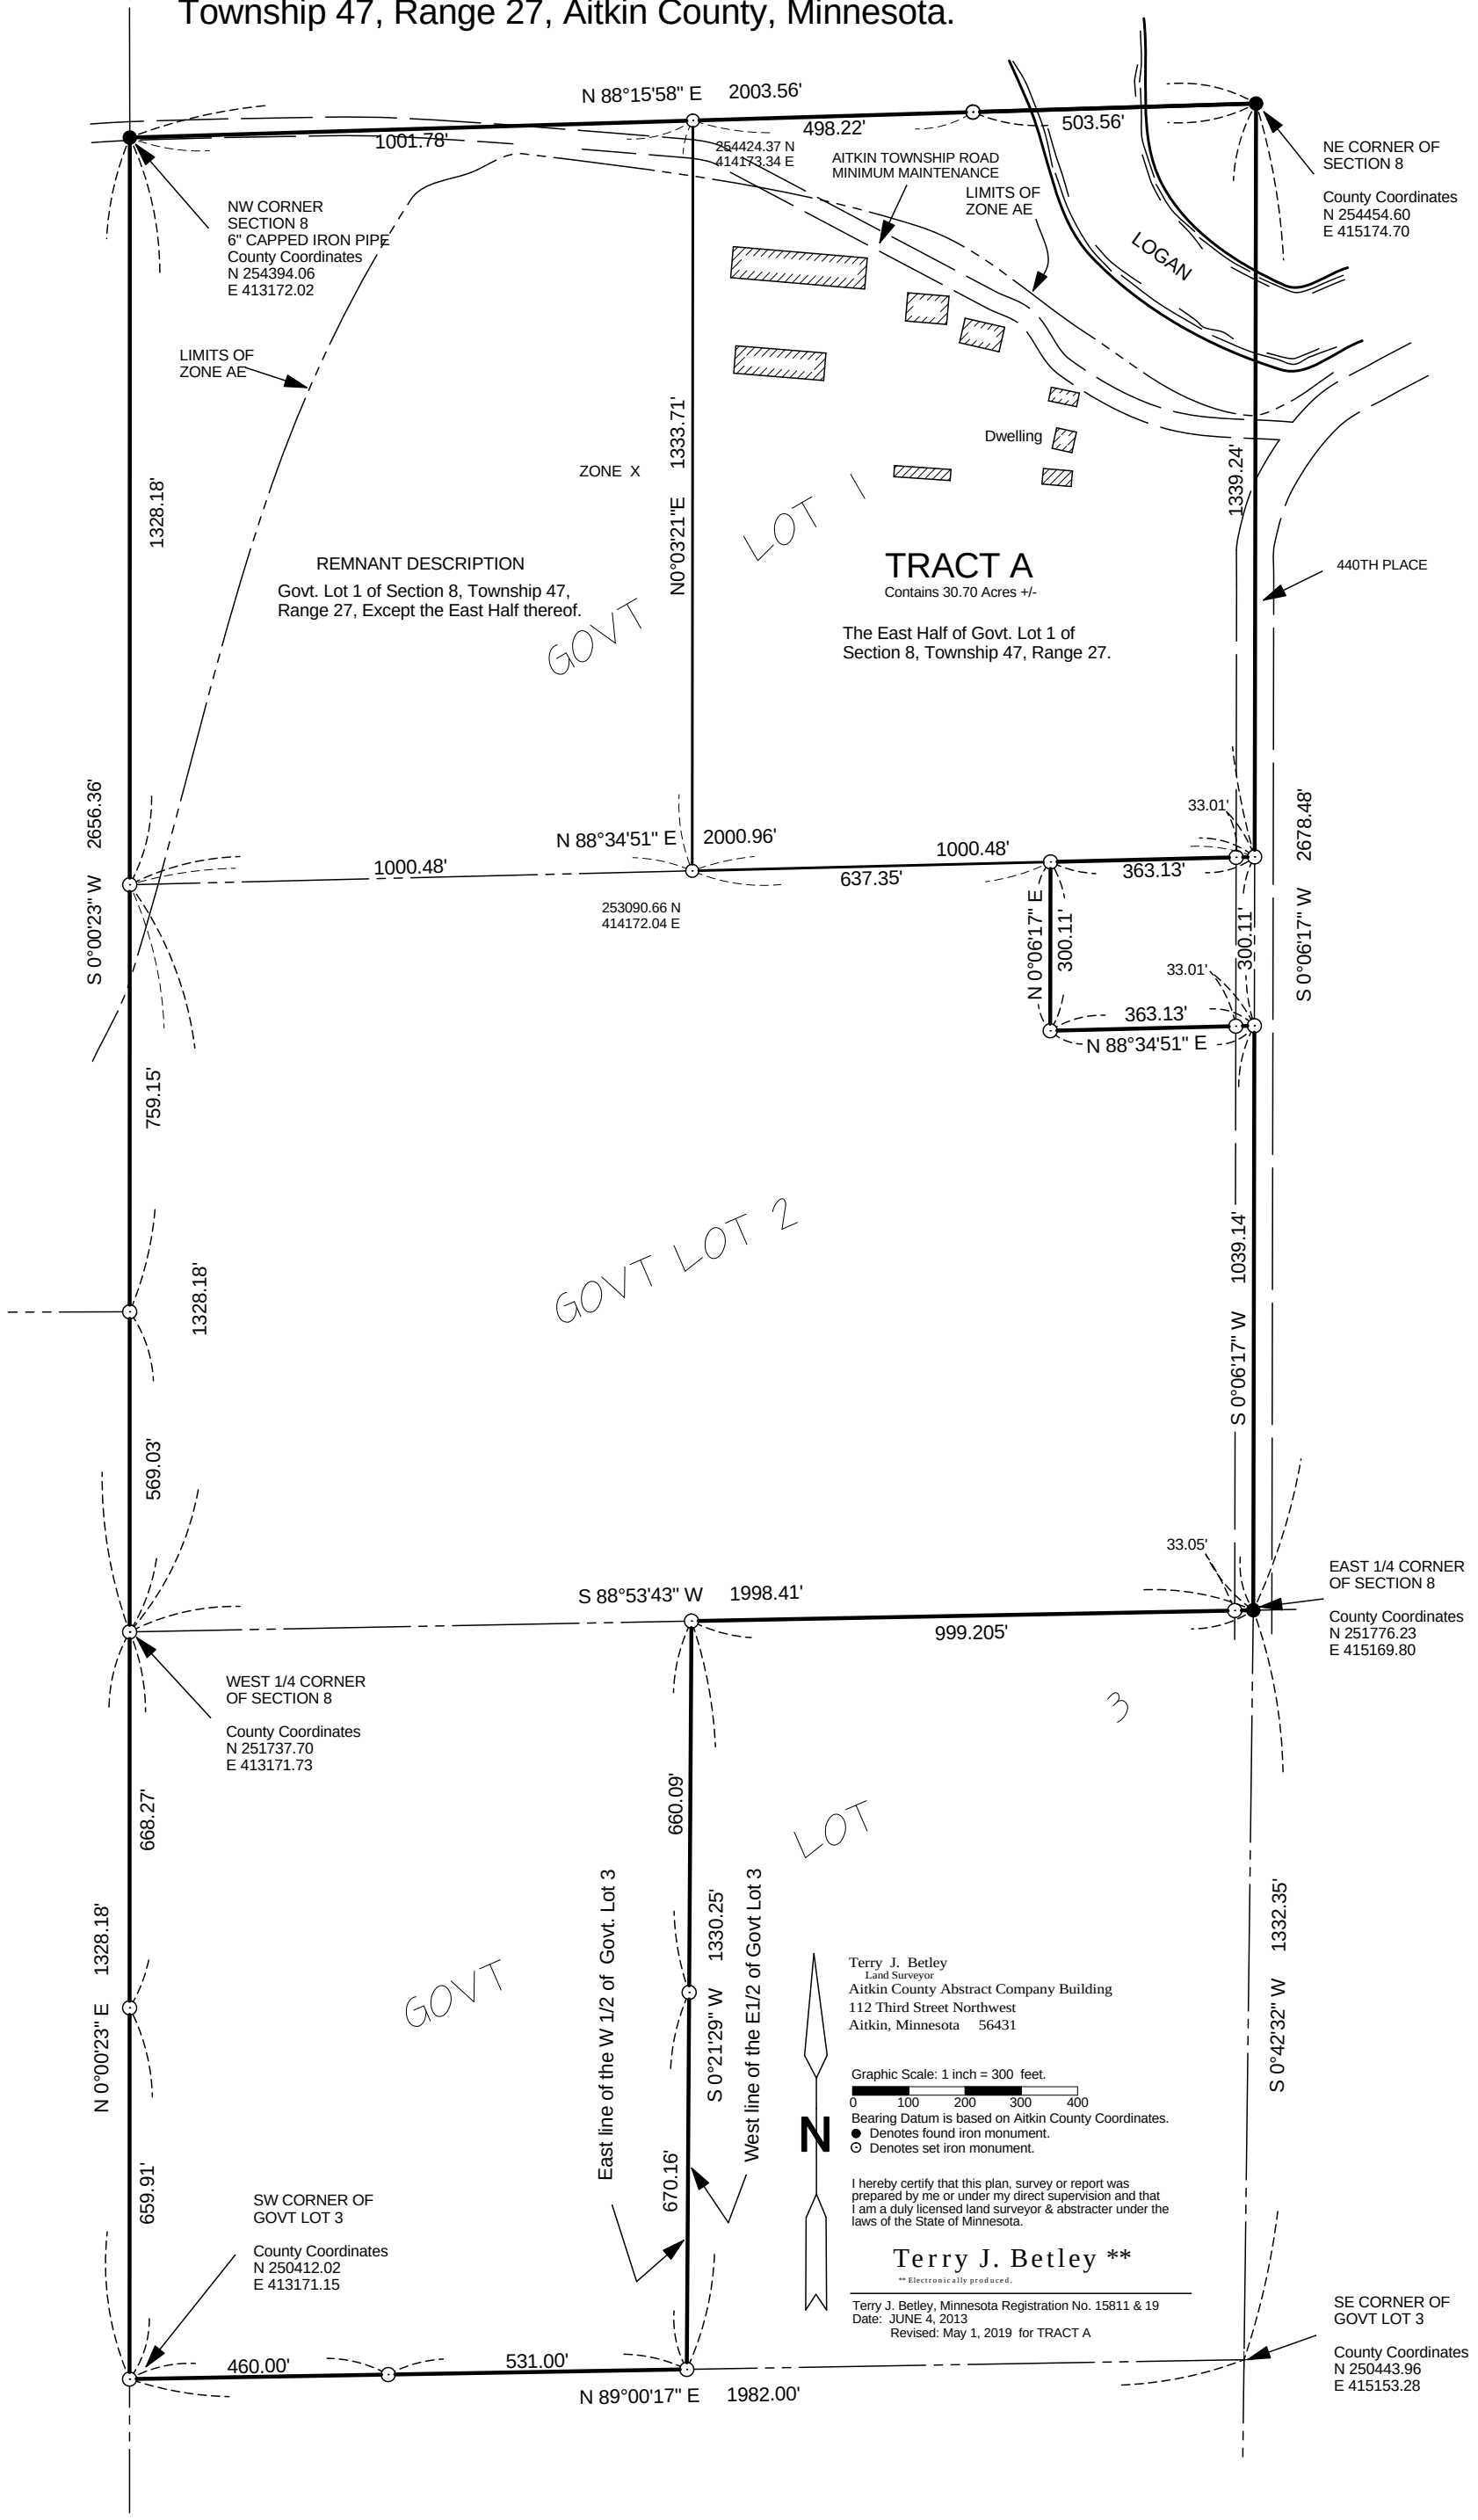
Of Government Lot 1 & a part of Government Lots 2 and 3 of Section 8, Township 47, Range 27, Aitkin County, Minnesota.