


7102

North

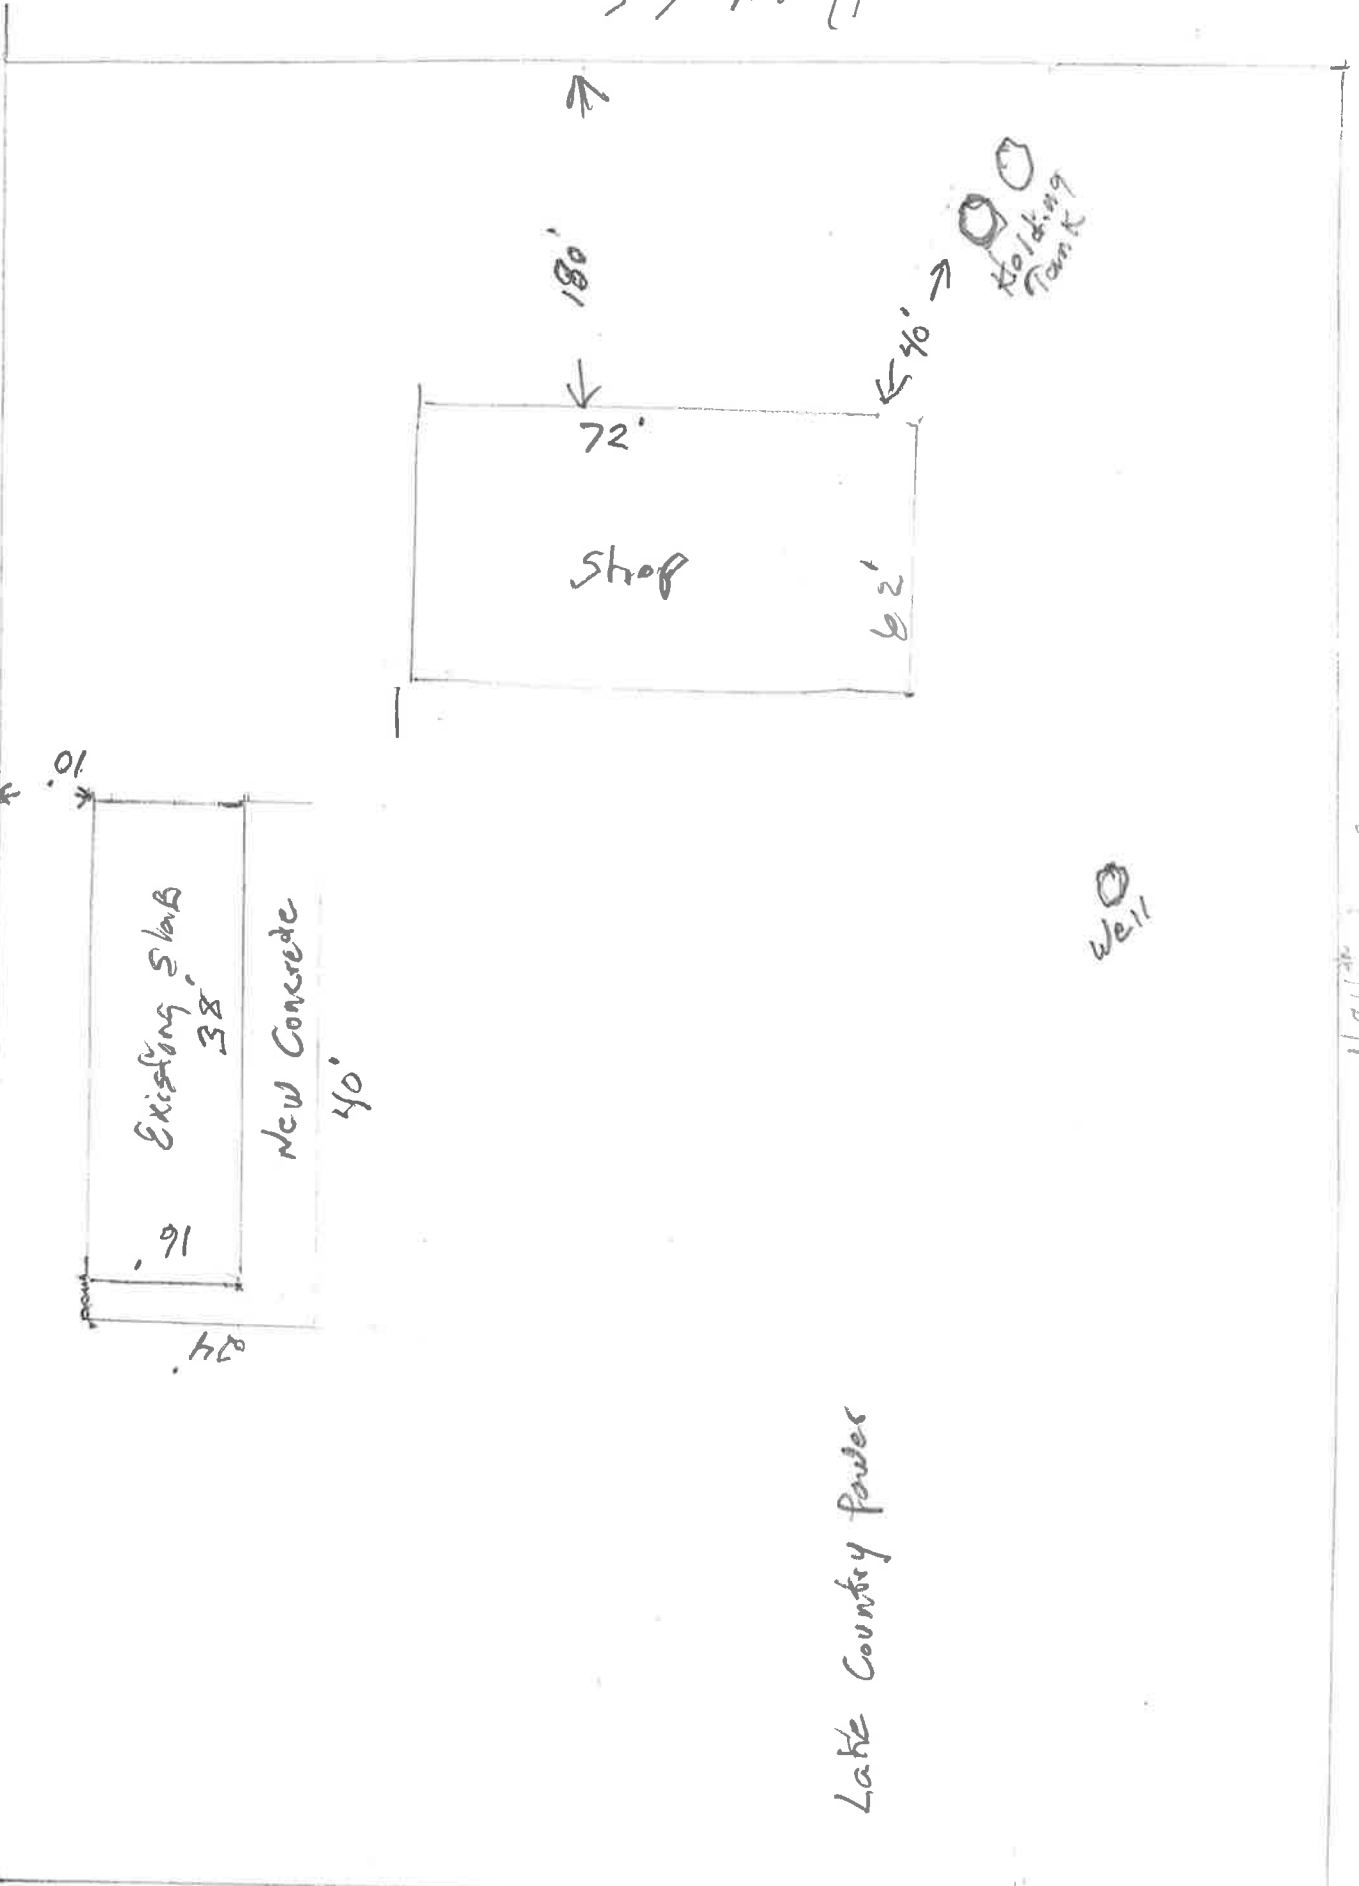

Lake Country Power

Well

Holding Tank

Shop

Existing Slab

New Concrete

10'

38'

16'

40'

40'

180'

72'

62'

40'

May 65

484<sup>th</sup> Lane