


North

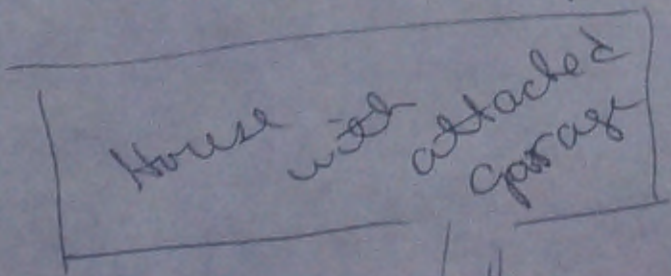

Septic tanks

Septic mound

Approx 200'

Service Door

Slide Door

30'

Slide door

75'

PROPERTY LINE

Atkin CR 38



2019/05/14



2019/05/14



2019/05/14