


EXISTING ROOF - 2535 cu ft
 ROOF HEIGHT - $4' 10\frac{1}{2}''$
 ROOF WIDTH - 26'
 ROOF LENGTH - 40'

EXISTING FOUNDATION - 1104.30 cu ft

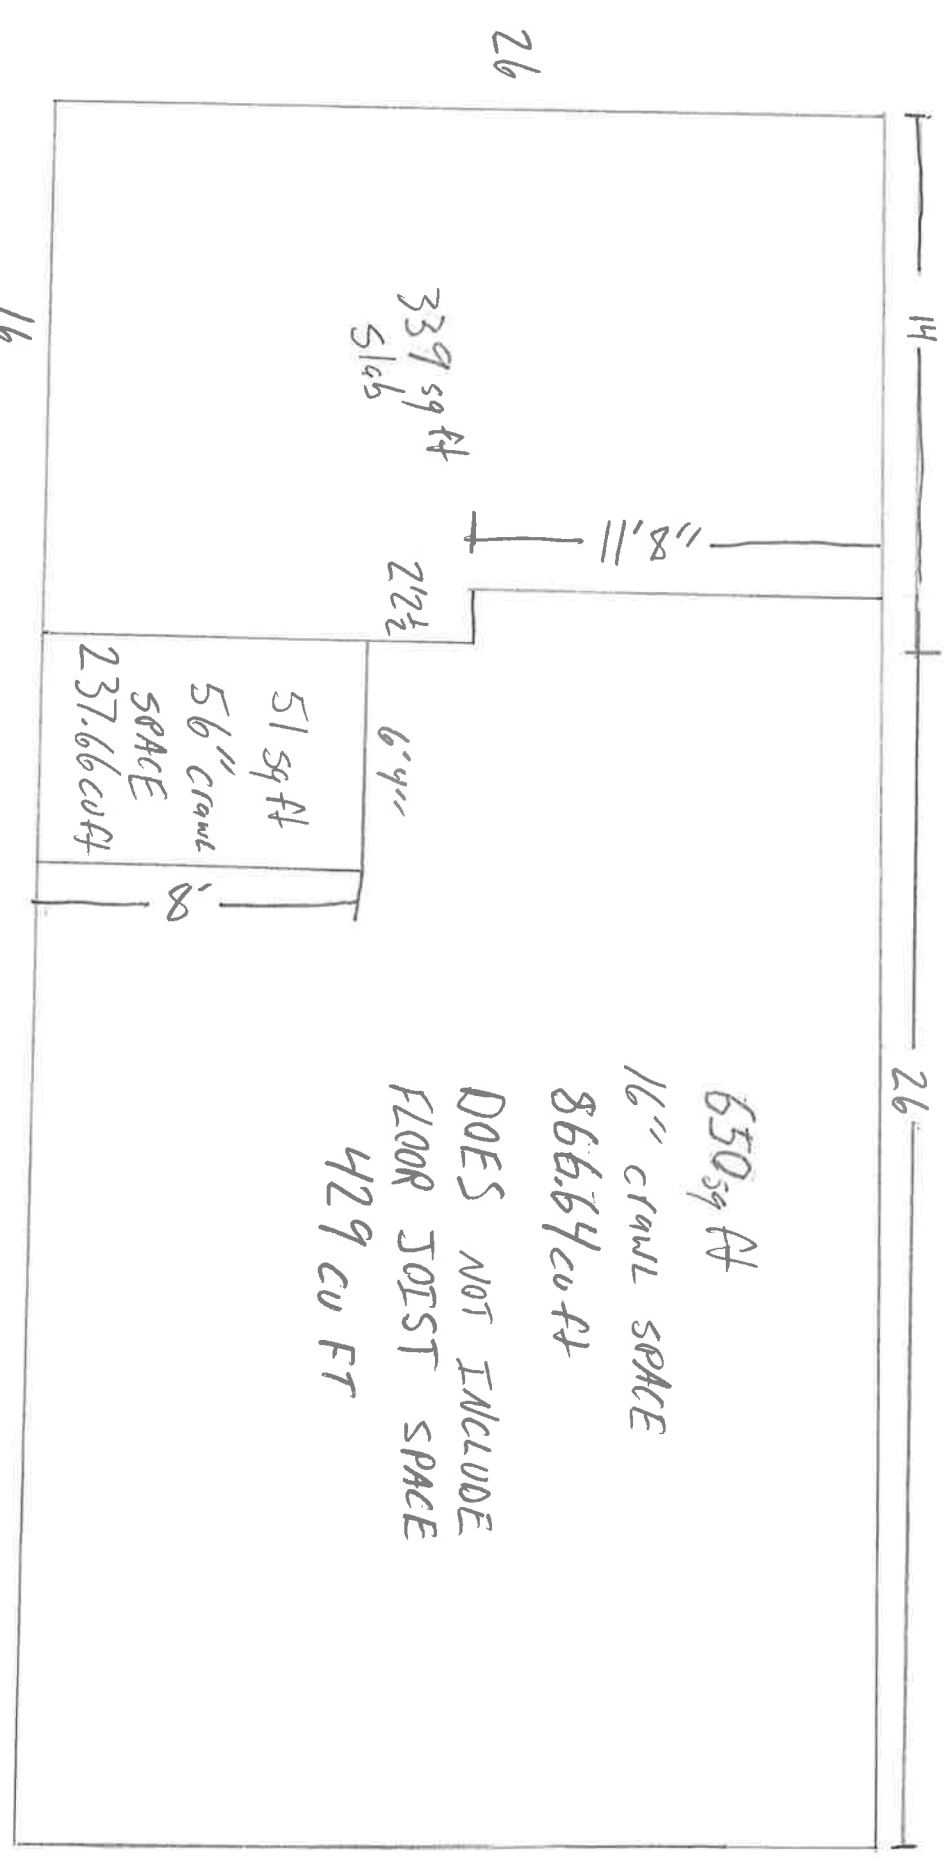

16

26

14

26

339 sq ft
slab

2'12"

6'4"


51 sq ft
56" crawl
SPACE
237.66 cu ft

650 sq ft
16" crawl space
866.64 cu ft
DOES NOT INCLUDE
FLOOR JOIST SPACE
429 cu ft


118"

16"


ROOF MEASUREMENTS

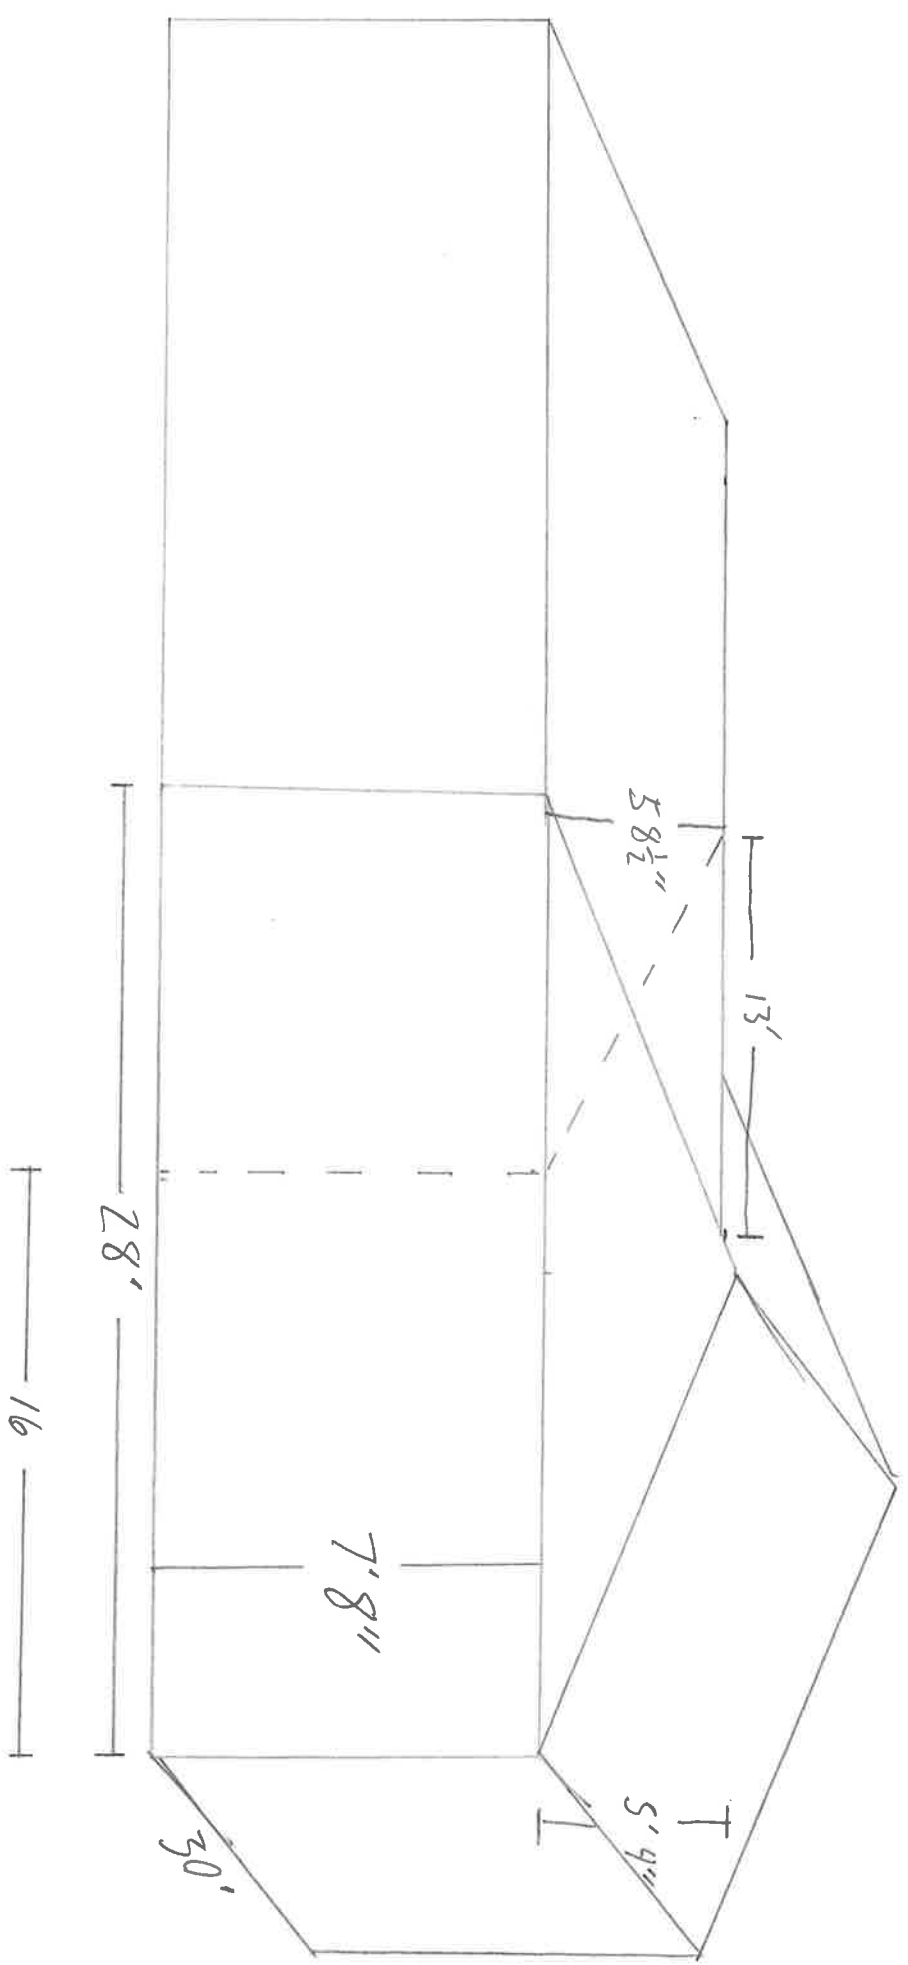

EXISTING LIVING SPACE - 8425.286 CU FT

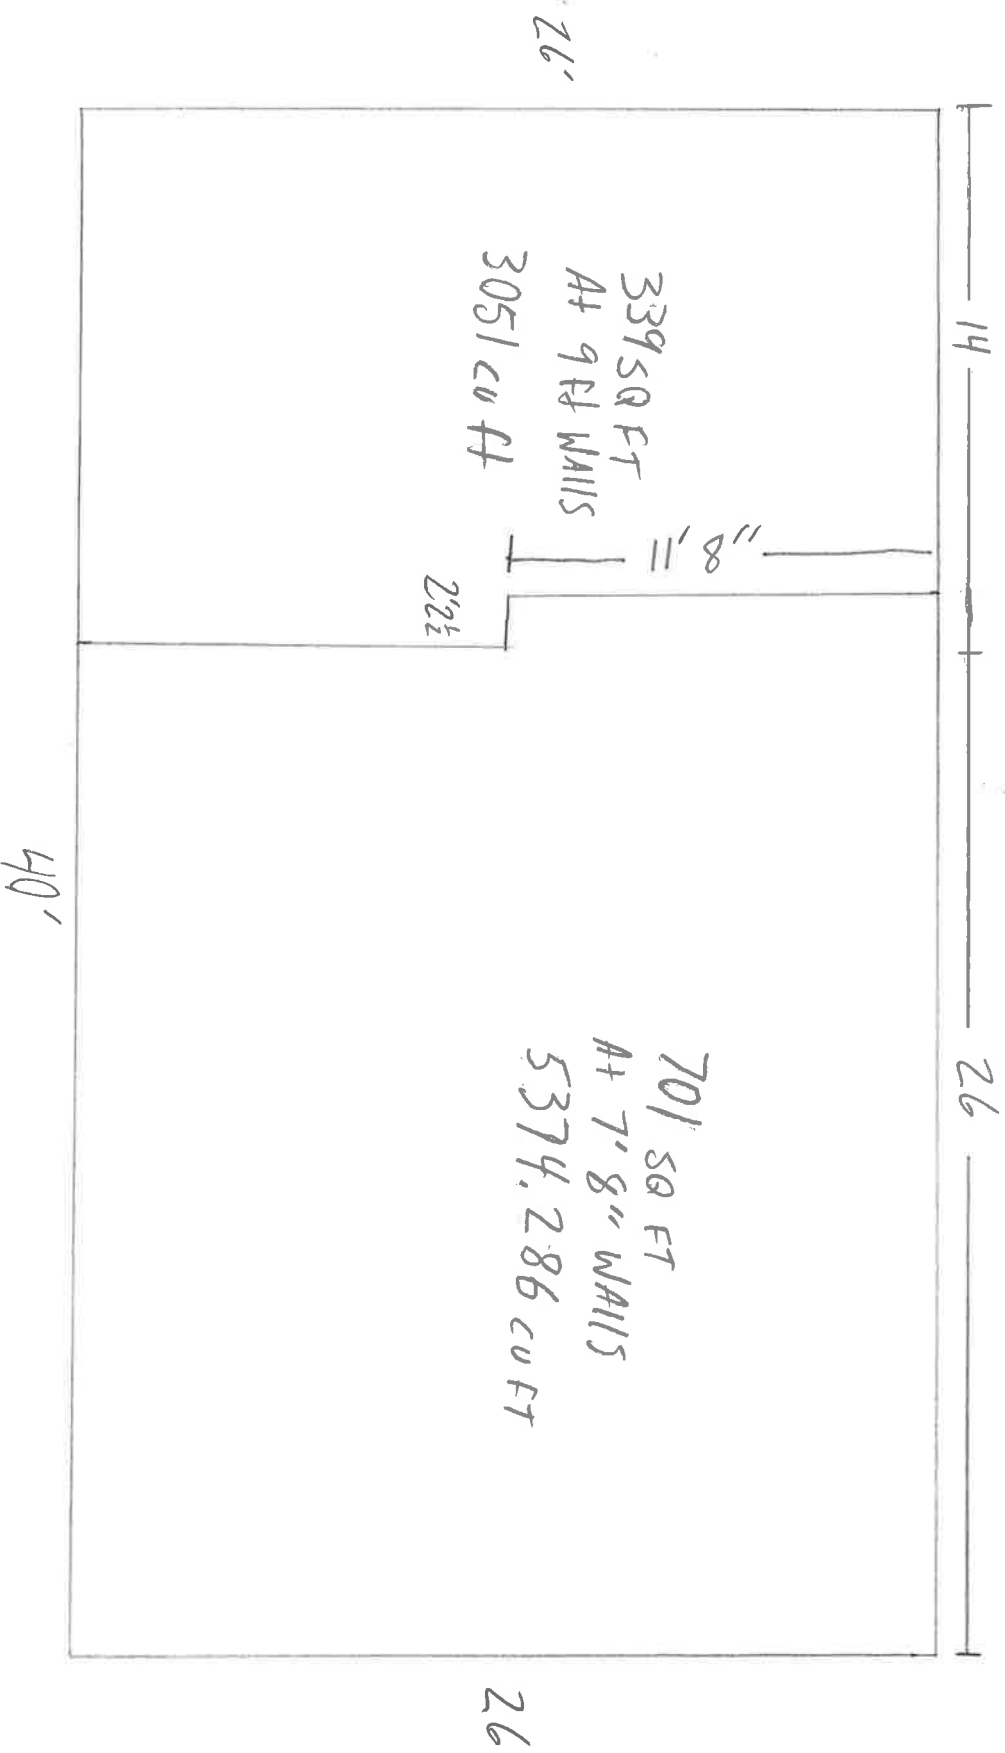

ADDITION LIVING SPACE - 4044.48 CO FT
Slab ON GRADE

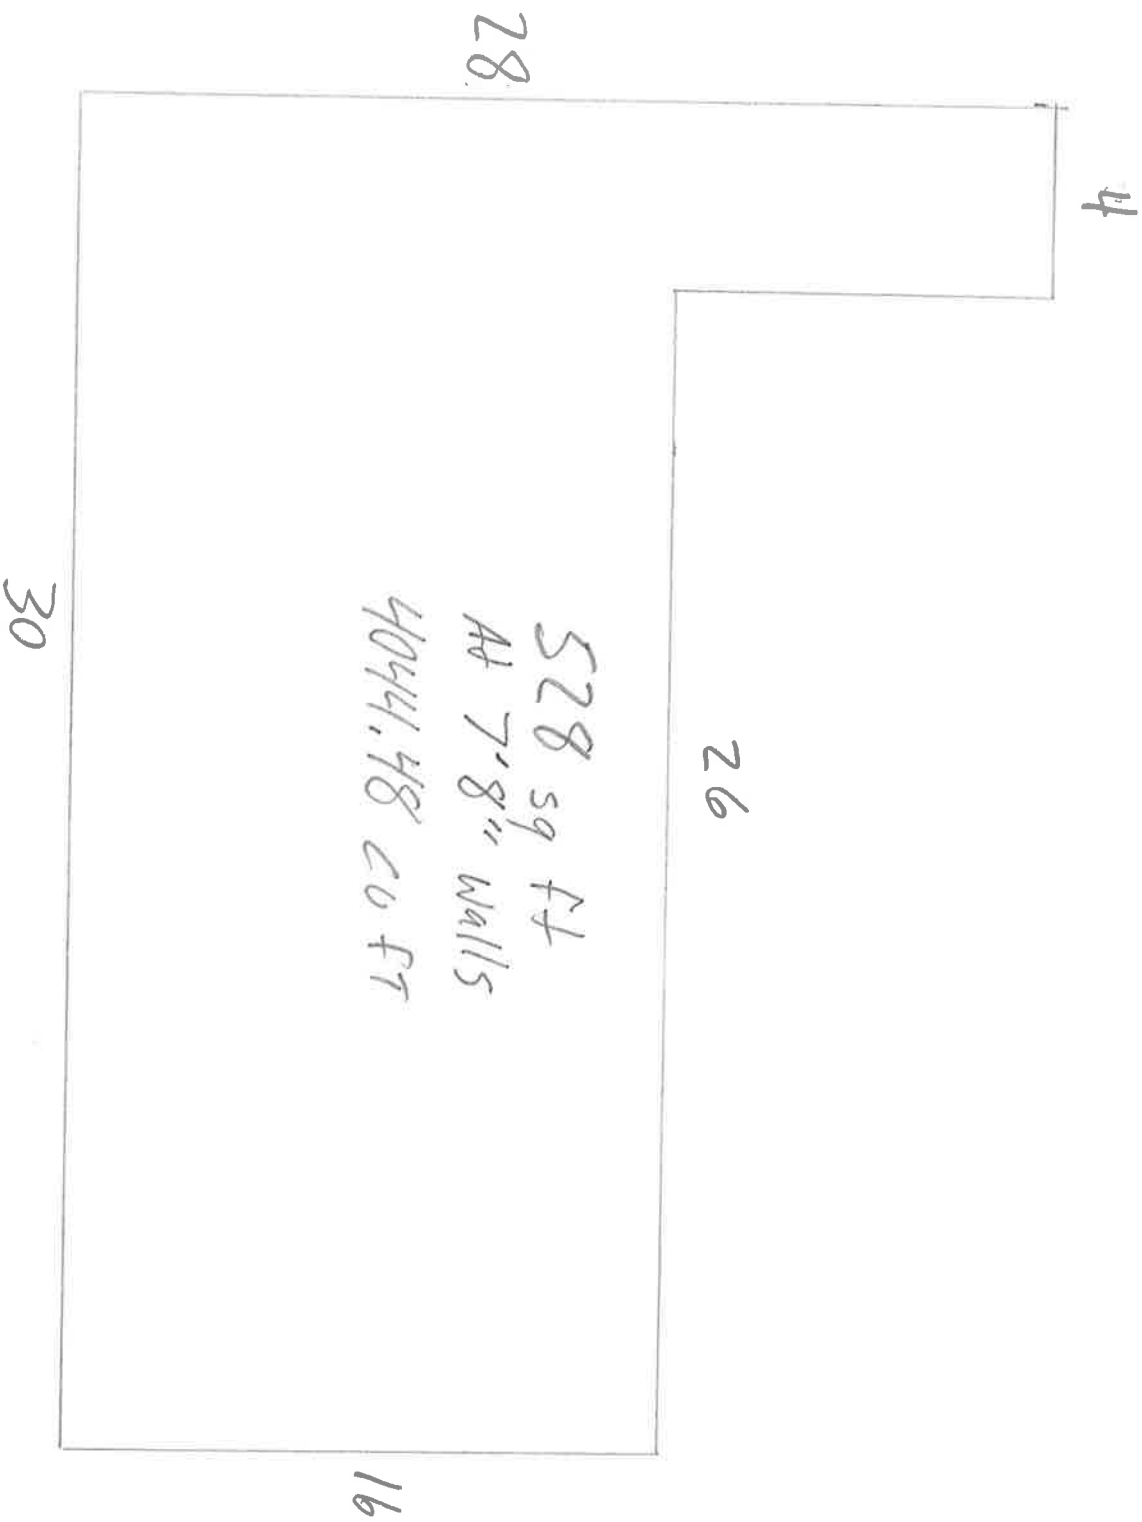

NEW + EXISTING ROOF
EXISTING SHADED
NEW ROOF CV F7-1933.97

