


Certificate of Survey

Part of Lot 2, SUNNYSIDE BAY TOWNSITE
 Section 26, Township 43 North, Range 22 West,
 Aitkin County, Minnesota.

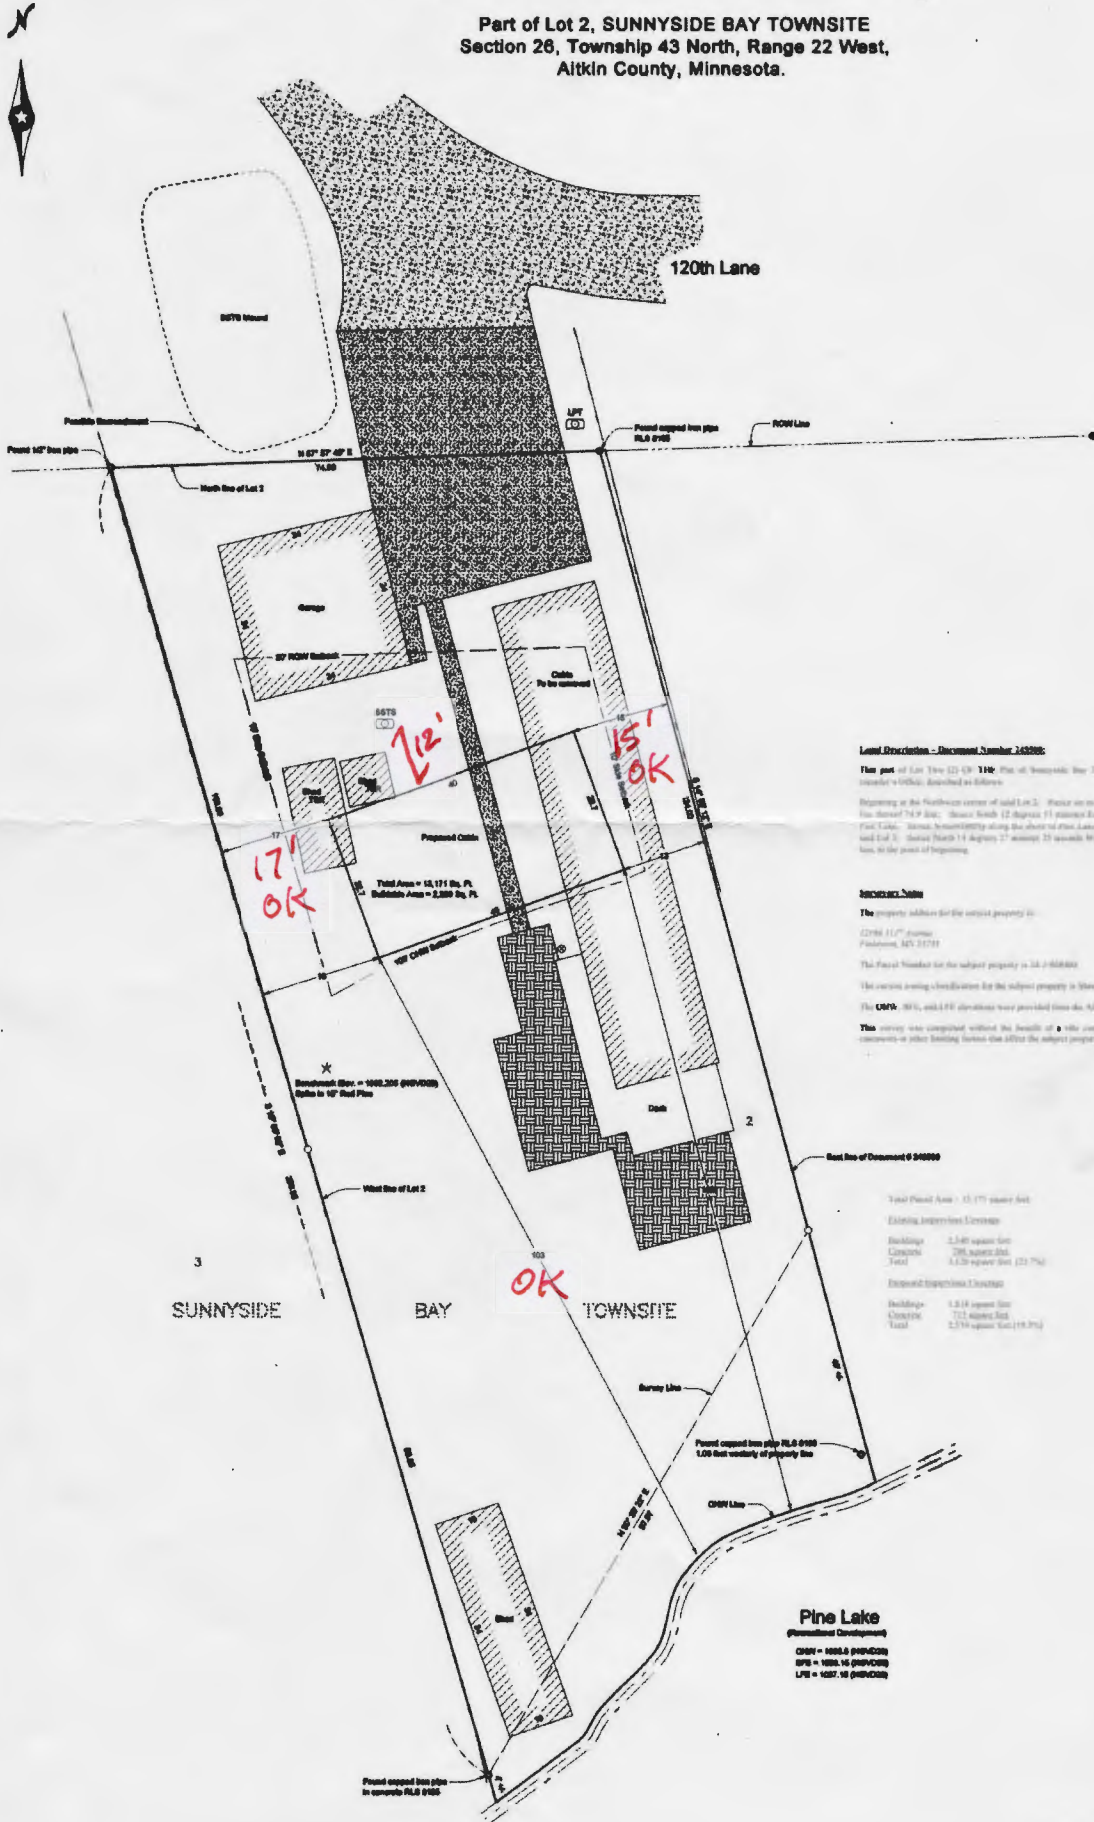

Land Description - Document Number 245295





The property address for the subject property is:
 This survey was completed without the benefit of a title examination or title opinion; there may be encumbrances or other building fixtures on the subject property that are not shown on this survey.






Pine Lake






Client Name: Larry Clum