


SEPTIC & DRAIN FIELD IS 72'-95' FROM DECK

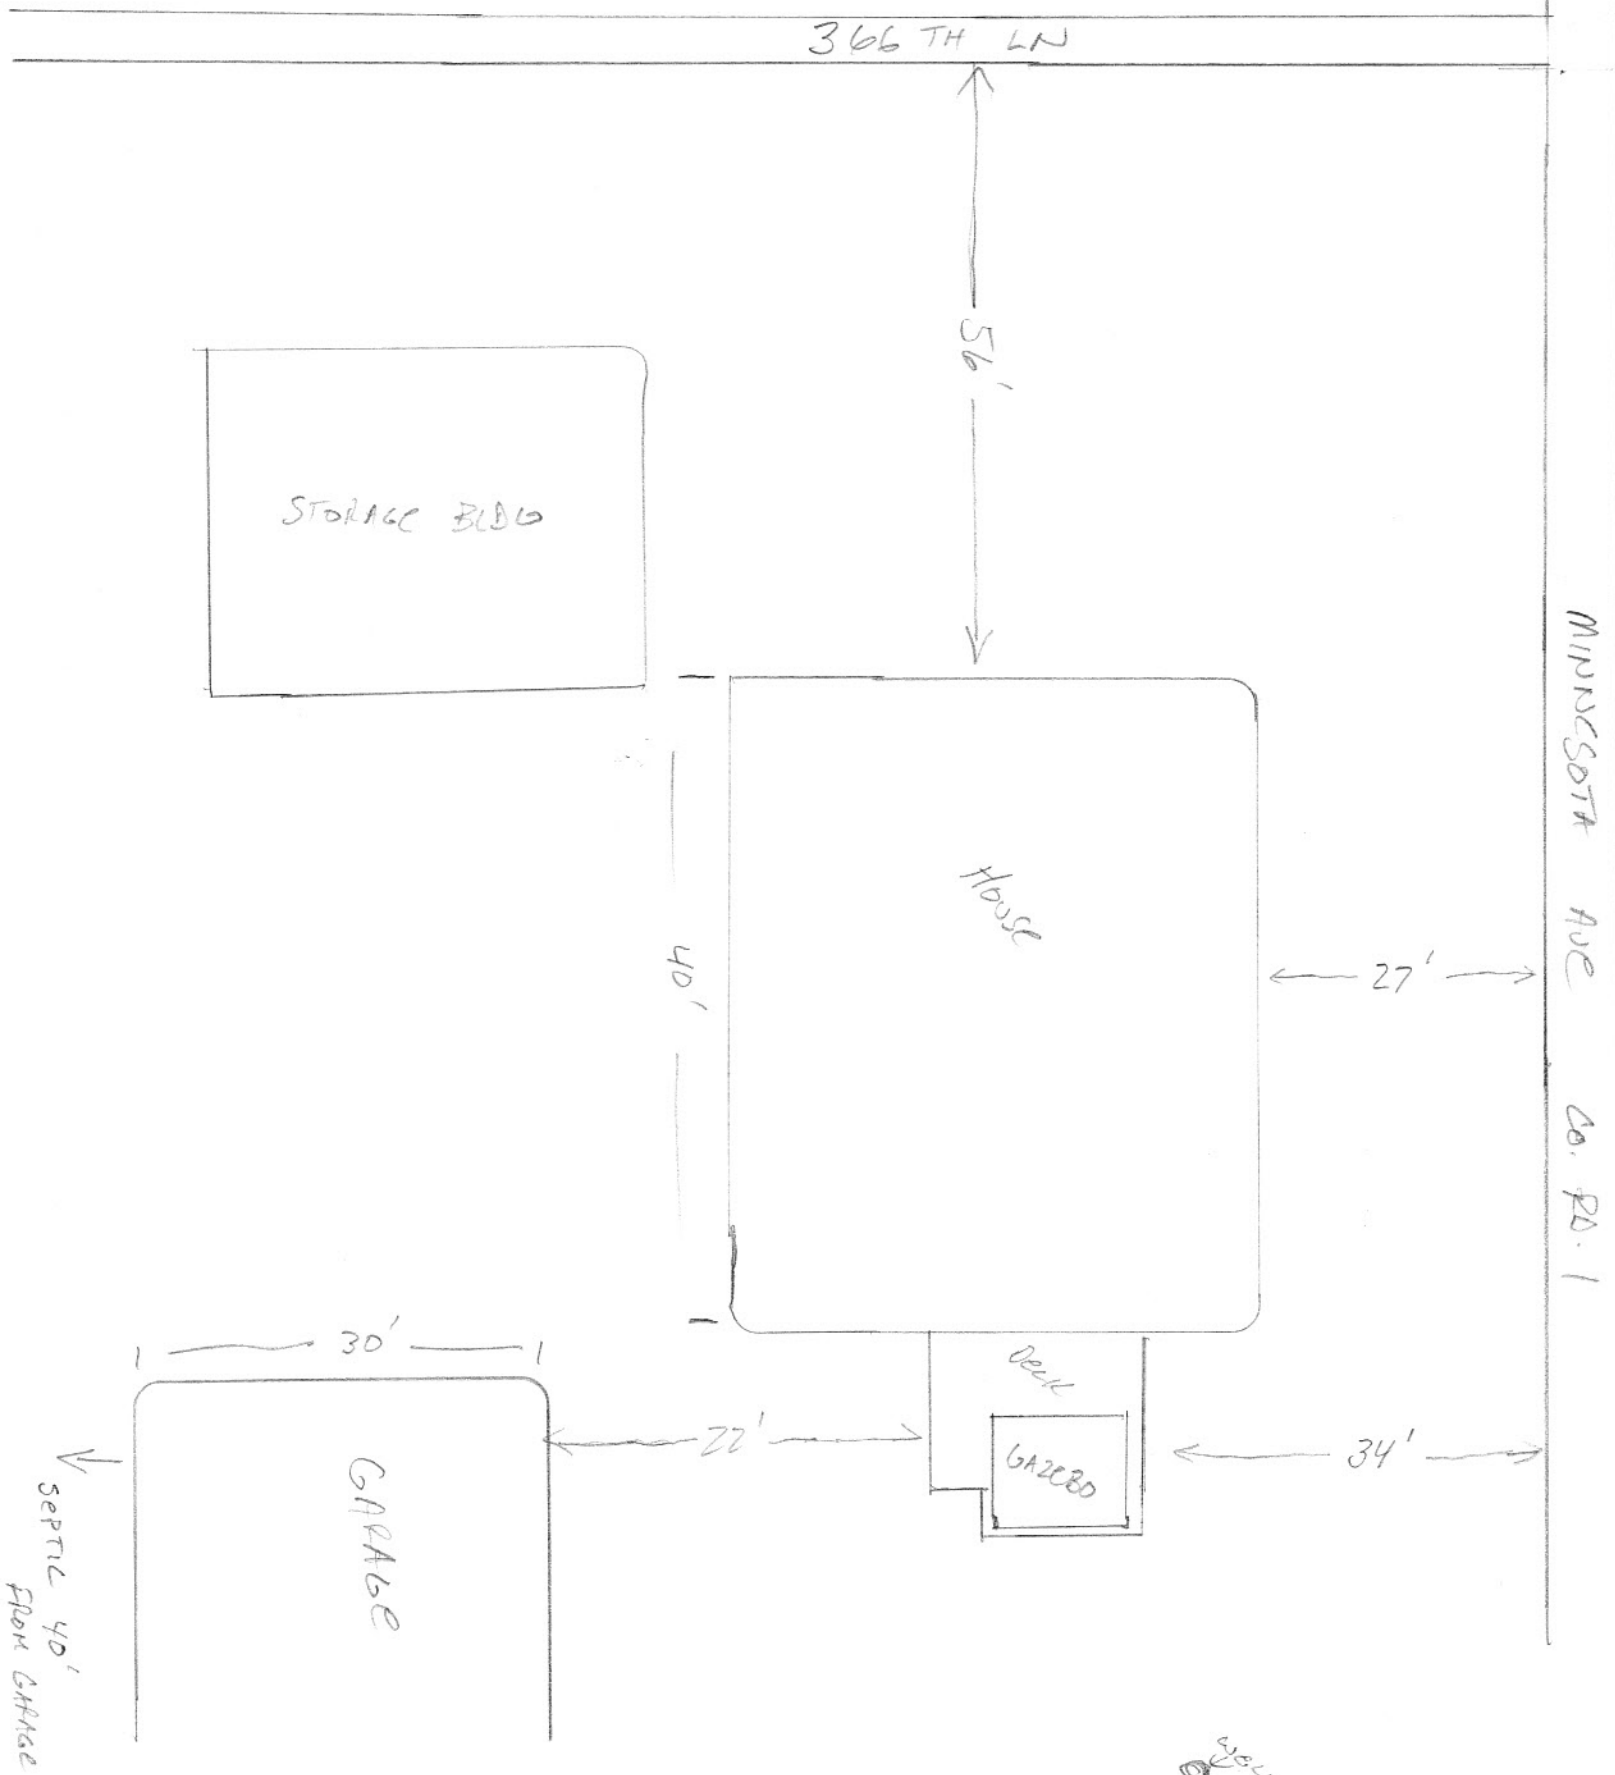

MINNESOTA AVE CO. PD. 1

W. J. [unclear]