



- Vosika JOB - Lake Winnemucca

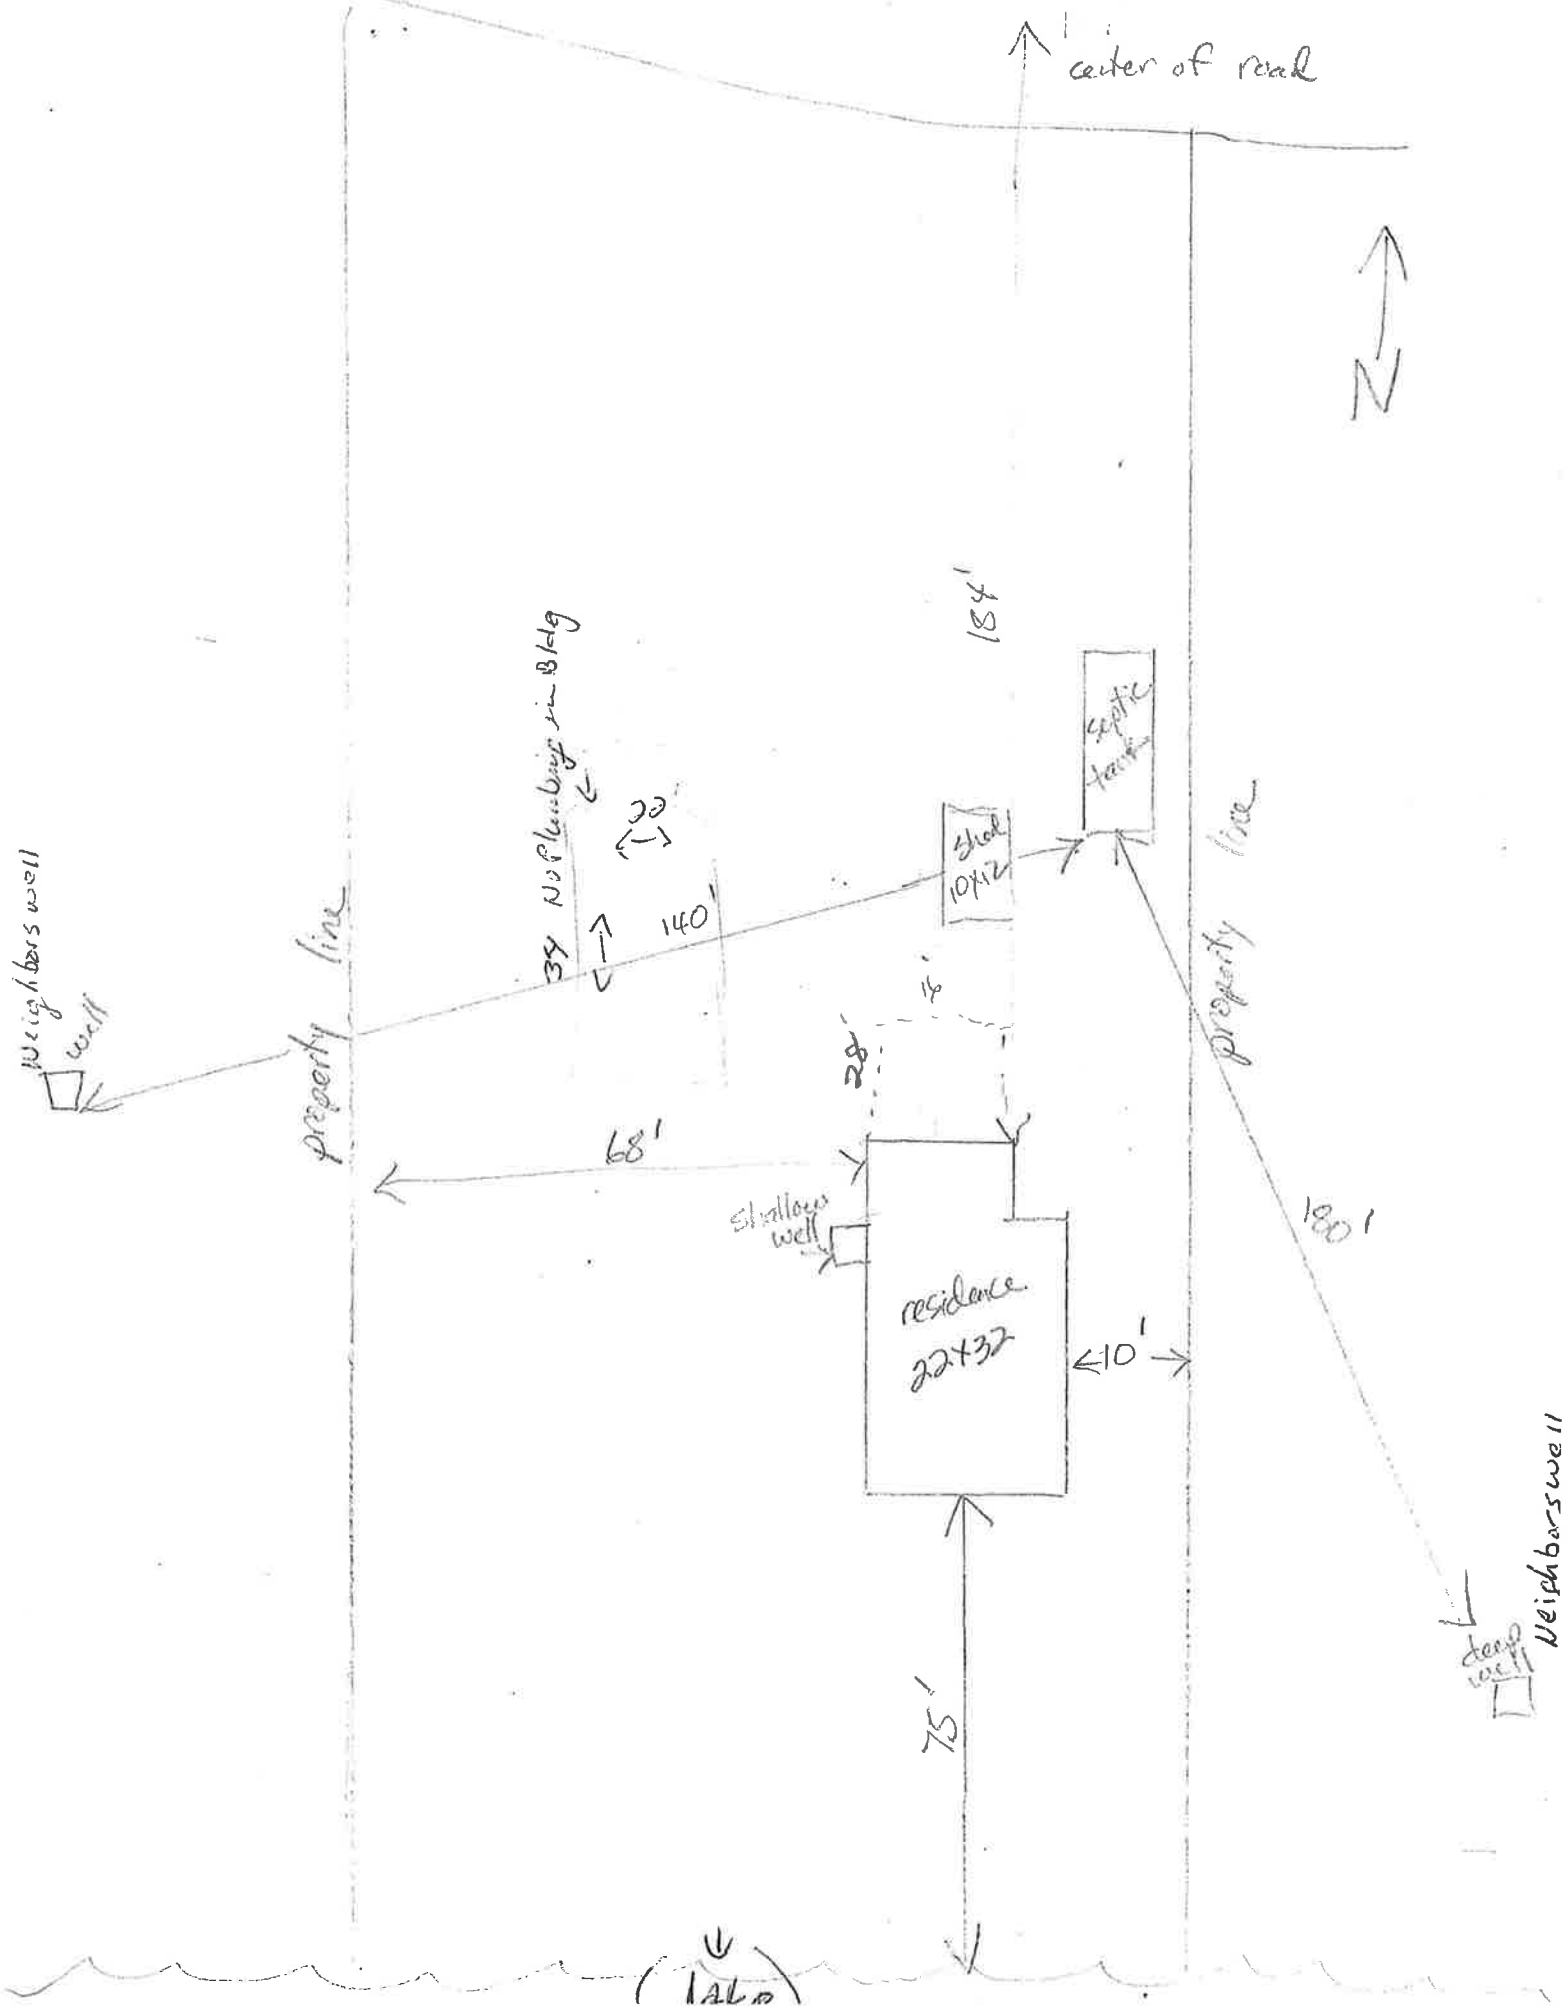

# Building Sketch

Borrower	VOSIKA, DARRELL & BETHELDA				
Property Address	20037 485th Ln				
City	McGregor	County	Aitkin	State	MN
Lender/Client	Affinity Plus Federal Credit Union				
				Zip Code	55760

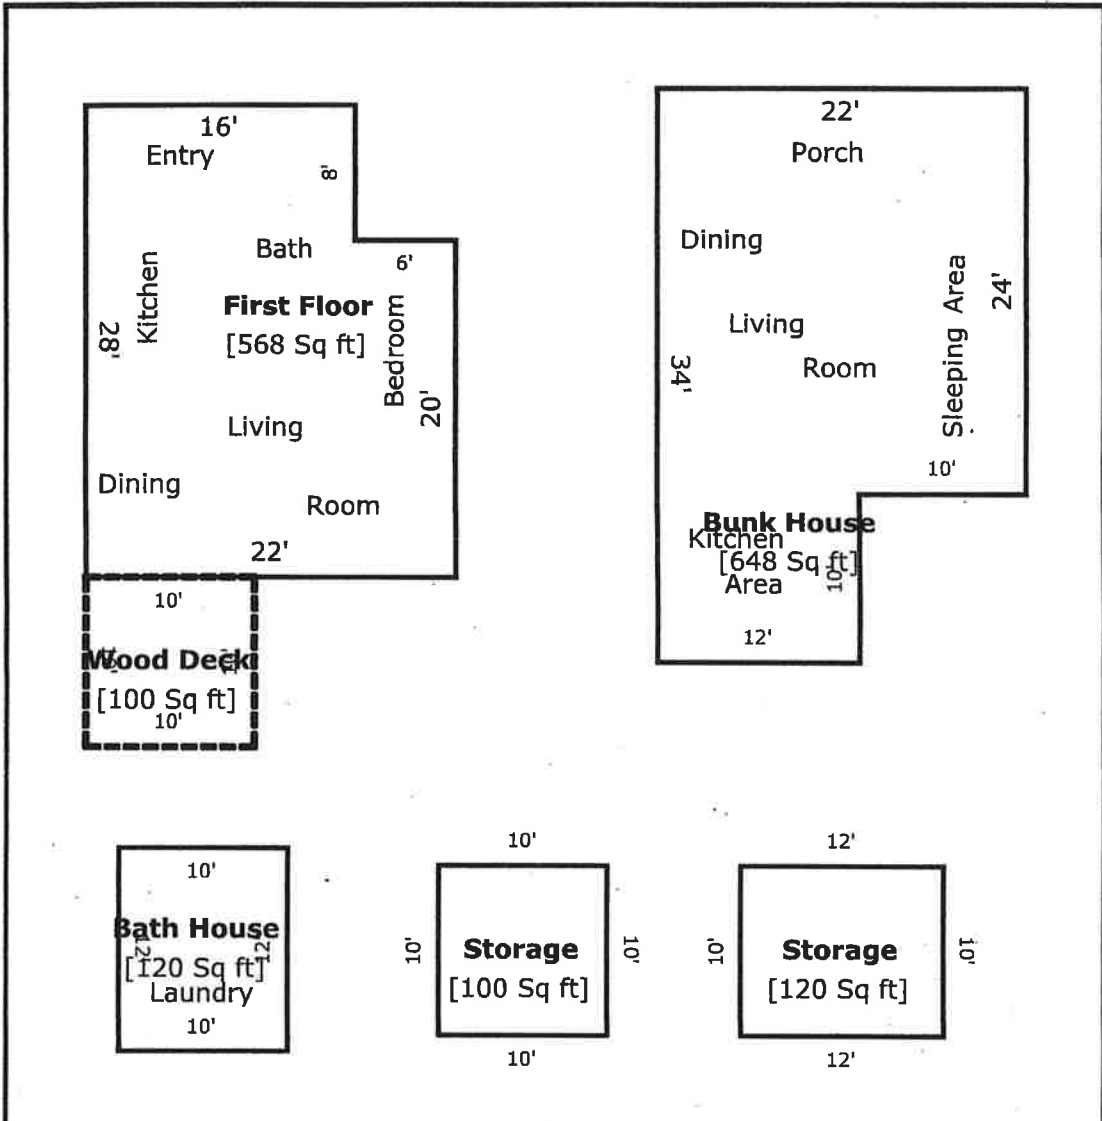

TOTAL Sketch by a la mode, Inc. Area Calculations Summary

Living Area		Calculation Details
First Floor	568 Sq ft	22 x 20 = 440 16 x 8 = 128
<b>Total Living Area (Rounded):</b>	<b>568 Sq ft</b>	
<b>Non-living Area</b>		
Storage	100 Sq ft	10 x 10 = 100
Storage	120 Sq ft	10 x 12 = 120
Bath House	120 Sq ft	10 x 12 = 120
Wood Deck	100 Sq ft	10 x 10 = 100
Bunk House	648 Sq ft	22 x 24 = 528 10 x 12 = 120