


These data are provided on an "AS-IS" basis, without warranty of any type, expressed or implied, including but not limited to any warranty as to their performance, merchantability, or fitness for any particular purpose.

Big Sandy 1223.9 100yr flood power pole has spike at 1225.61 for elevation certified

14-0-040101

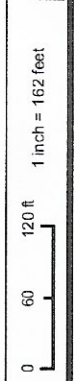

Date: 6/14/2019