


Plat Drawing

(This is not a Survey)

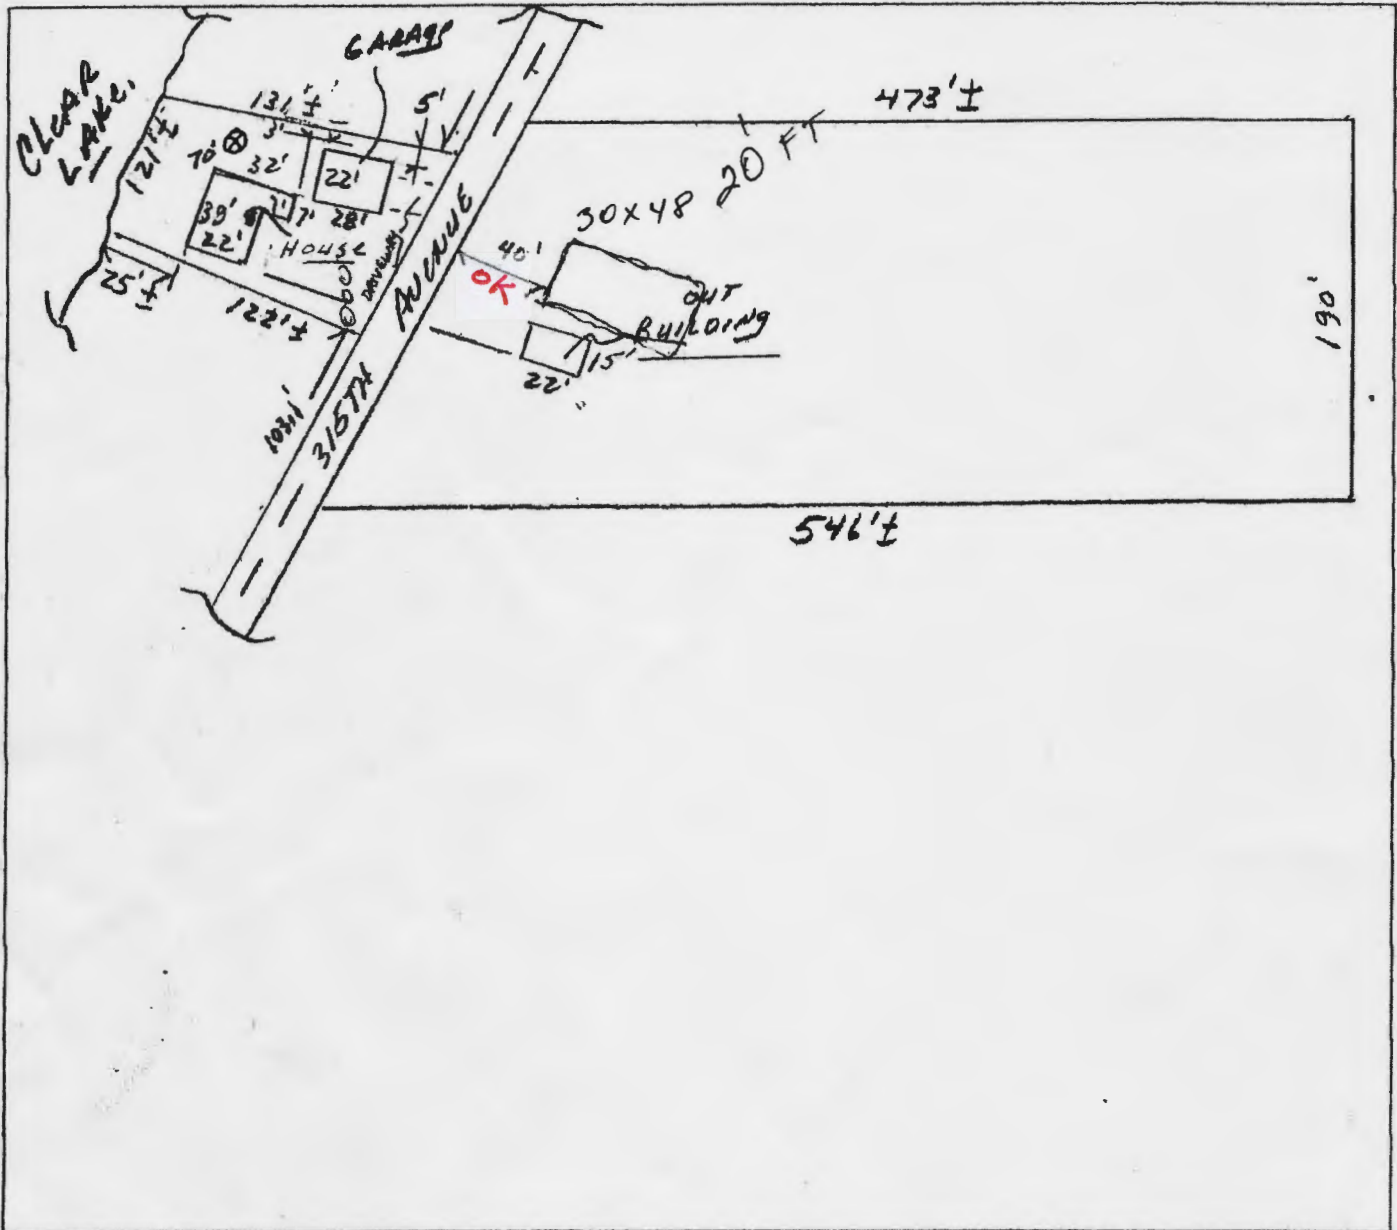

File # 19128 Buyer / Owner: NORBY / ISAAK
Property Address: 28257 315TH AVENUE, AITKIN, MN
Legal Description: P/O SOUTH 190' of NORTH 250' of LOT 6,
SEC. 9 TWP. RANGE
Date: 5 / 09 / 19 By Bill Schoenecker

The location of the improvements shown on this drawing are approximate and are based on a visual inspection of the premises. The lot dimensions and legal description values are taken from the recorded plat and/or county records. This drawing is for informational purposes and should not be used as a survey. For exact corner locations, consult a Registered Surveyor. This information does not constitute a liability of the Northpine Company and/or Bill Schoenecker, and is intended for mortgage purposes only.



2019/06/28



2019/06/28



2019/06/28