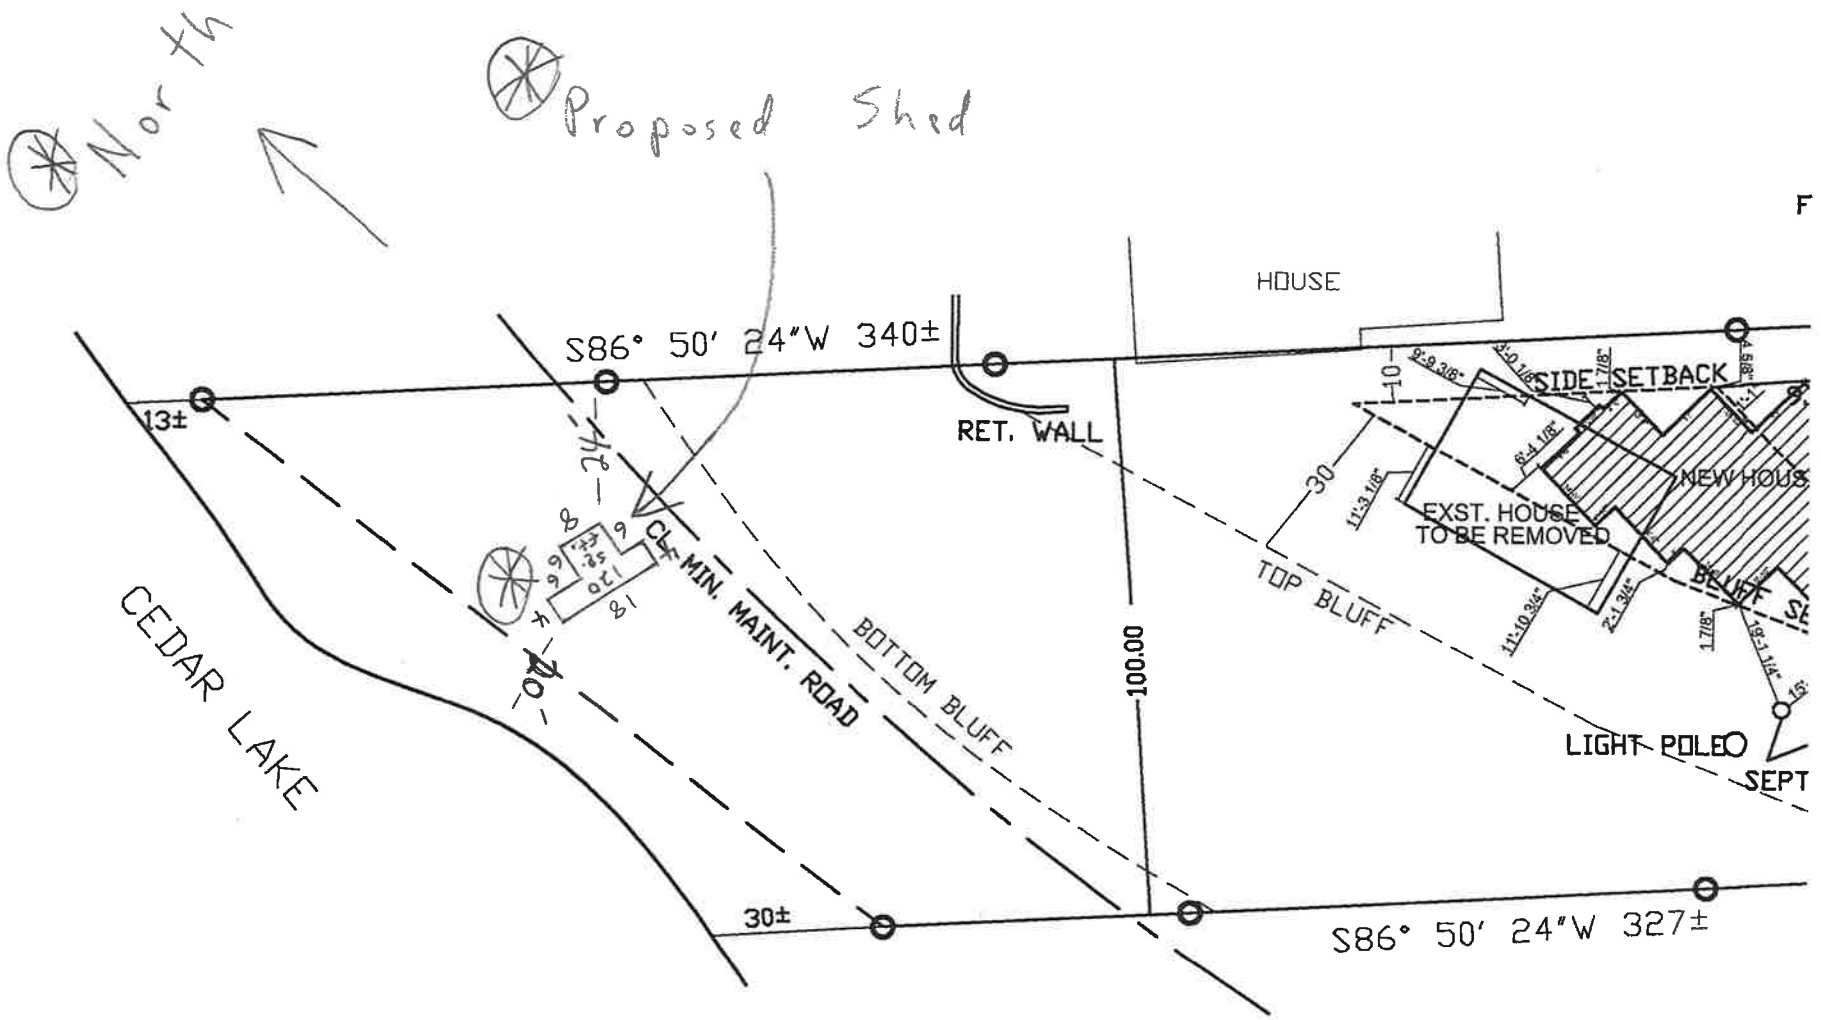OF PART OF GOVT. LOT 5,
SEC. 33, TWP. 47, RNG. 27,
AITKIN COUNTY, MINNESOTA