

Doc. No. 358879

Parcel
9.25 acres

N00°47'00"W
450.02

S00°47'00"E
679.09

N00°47'00"W
225.11


N00°47'00"W
229.07

NE OF GOV'T LOT 1

490th LANE

S89°01'19"E
290.14

35' to 490th Lane

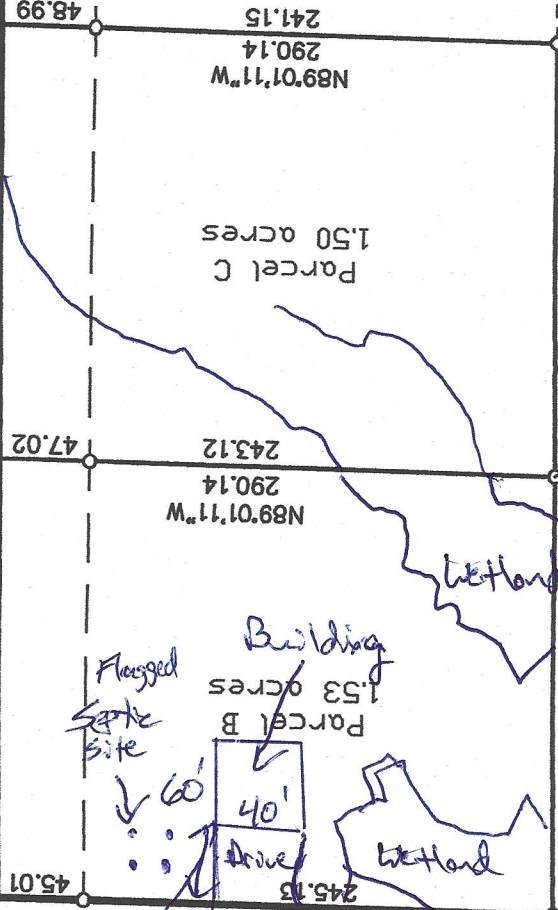

Aitkin County Highway Right-of-Way Plat No. 4

N ↓