

N
↑



Field

Woods


Woods

wood line

↑
50'

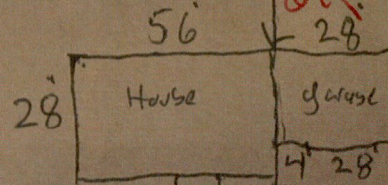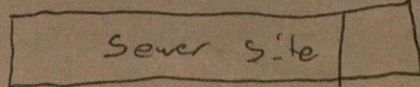

well

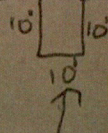

160' OK

New Drive wall

190' Drive wall



2019/07/29



2019/07/29



2019/07/29