


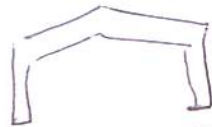


→ Bricked Area would have screen porch added at the end of cabin.



less than 360 sq. feet.

- match roof
  - screen added - to have shelter from bugs.
- 12 x 30

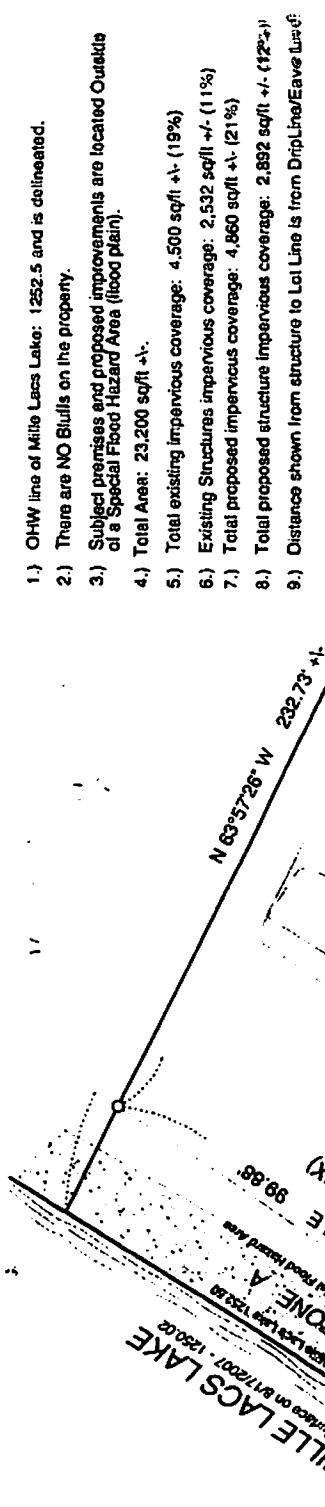

- 1.) OHW line of Millie Leacs Lake: 1252.5 and is delineated.
- 2.) There are NO Bluffs on the property.
- 3.) Subject premises and proposed improvements are located Outside of a Special Flood Hazard Area (flood plain).
- 4.) Total Area: 23,200 sq/ft +/-.
- 5.) Total existing impervious coverage: 4,500 sq/ft +/- (19%)
- 6.) Existing Structures impervious coverage: 2,532 sq/ft +/- (11%)
- 7.) Total proposed impervious coverage: 4,860 sq/ft +/- (21%)
- 8.) Total proposed structure impervious coverage: 2,882 sq/ft +/- (12%)
- 9.) Distance shown from structure to Lot Line is from Drip Line/Eave Line +/-.

Terry J. Batley  
 Licensed Surveyor  
 Aitkin County Abstract Company Building  
 112 Third Street Northwest  
 Aitkin, Minnesota 56431

Graphic Scale: 1 inch = 30 feet  
 Bearing Datum is Local Assumed.  
 ● Demos found on monument.  
 ○ Demos set on monument.

I hereby certify that this plan, survey or report was prepared by me or under my direct supervision and that I am a duly licensed land surveyor & abstractor under the laws of the State of Minnesota.

*(Signature)*

Terry J. Batley, Minnesota Registration No. 19611 & 19  
 Dated SEPTEMBER 20, 2007

My True and Correct Seal and Signature

### Certificate of Survey

Of Lot 6, Henry's Estates, Aitkin County, Minnesota.

PID: 16-1-078300