AITKIN COUNTY CERTIFICATE OF INSTALLATION/NOTICE OF NONCOMPLIANCE


This certificate of	of installation/ not	tice of noncomplian	ce has been issued this
Aitkin Countr's	Subaurface Sow	, 20 to certil	fy compliance\ noncompliance with tem Ordinance.
The premises of	overed by this co	age mealment bys artificate are legally	described as:
The premises co	overed by this ec	ortificate are legally	described as
Section	Township	Range	Lake
PERMIT NO		_ Owner Name	Lake
Address			
Installer Name _			
Type of System	Inspected		
Parcel Number_			
following: 1) Inspect	tion of the instal	lation or constructio	ee was based on No of the
reierence	a permit and ap	plication design.	
•	•		rdance with Subdivision 9.2 D of ent System Ordinance.
Aitkin County's S shall serve as a	Subsurface Sewa Notice of Violation	age Treatment Syston:	t system is in noncompliance with tem Ordinance, then the following spections or investigations:
2) List of s	specific violation	s of Ordinance:	
3) Require	ements for corre	ction or removal of	violations:
4) Time so	chedule for com	pliance:	
turned over to th	ne Aitkin County	Attorney's Office for	will result in this matter being or further legal action, which may and/or imprisonment.
INSPECTOR SIG	SNATURE		

SUBSURFACE SEWAGE TREATMENT SYSTEM INSPECTION FORM AITKIN COUNTY, MINNESOTA

All All COOK	2019-4900
Township <u>Shamvock</u> Date of Inspectio	8/23/2019 T $12/15/2020$ F App. Number 44517
Owner Benton McCone	Parcel Number <u>29-/-324900</u>
Project Address 4951Z 20Z MPI.	Installer <u>Ekelund Exc.</u> Brad Eddy
City McGregor Zip Code 55	760 Brad Eddy T3 4BR
New Repair	DIST. or DROP BOX & TYPE
SETBACKS:	TRENCHES, BEDS, OR GRAVELLESS LEACHFIELD:
Buildings to tank(s) <u>Z0 '+</u>	Trench/Bed depth 24" (see notes)
Buildings to drainfield 30'+	Trench/Bed length 51 in L Shage
Well(s) 50' or 100' <u>DW: 100'+</u>	Trench/Bed bottom width 15'
Lake/Creek/Wetland Big Sardy Lakes: 100'+	Trench-spacing 3'
' - ' - <	Drainfield rock below pipe <i>9</i> "
SEPTIC TANKS: New Existing_	Size of gravelless pipe
Number of tanks installed	Depth of backfill _ / Z"
Liquid capacity and type <u>/350 table Ex</u>	Absorption area: square feet $765 + 2$
Type of baffle Plastic	lineal feet
Inspection pipes (2) *	MOUNDS:
Manholes size 24"	Percent slope
Manhole to grade Yes V No No	Upslope sand width
	Downslope sand width/
PUMPS: New Existing	Sideslope sand width
Tank capacity and type 1000 & ex.	Drainfield rock below pipe
Pump manufacturer & model # Zockler 152	Depth of sand below rock 24"
Horsepower & GPM /2HP 396PM	Perforation size & spacing $\frac{7/32"}{36"50}$.
Feet of head _/6'	Pipe size & spacing $2''/3'_{50}$.
Gallons per cycle <u>150 GPC</u>	Dimensions of rock bed $15' \times 51'$
Size of discharge line/. \(\section '' \)	Dimensions of sand base 17'× 55'
Type & location of alarm Elec. m tank	Final cover_12" cover over rb
Water meter Event counter	
DRAWING OF SYSTEM: (include soils) See attached = te plan	

Inspector's Comments: System put in 2019. However was never completed (T5 xtc)
I called Mr. Eddy, He said they had not now for the inch little character of it
until the pd. Didn't get done until lake fall 2020. I G wound. See notes on site plan.
Inspector's Signature Bryan Hargrave Installer's Signature

Site Drawing

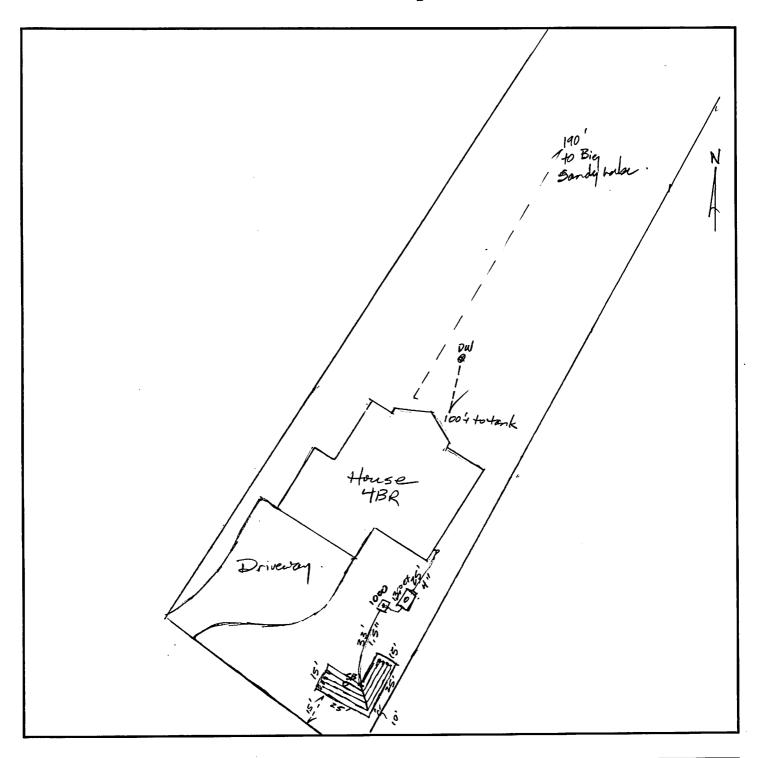

Soils				
A	0-12"	104RZ	/2	GSL
B	12-21"	7.54R4	1/3	GSL-XL
-	29"+	1.5TR4	14	M5
	Kedo	× Q 31"	7,5 PR	1/6

Notes Upper 2' very rocky, 35-50 % of Some horizons in excess of 5010. Dag out 2' of rocky material replaced w/ clean Sond. Then rock bed (Better of rls)
needs to be 5" above grade Homat
36" Sep. requirement. Then 12" cover
over rb.











