
AITKIN COUNTY CERTIFICATE OF INSTALLATION/NOTICE OF NONCOMPLIANCE

This certificate of	of installation/ not	tice of noncomplian	ce has been issued this
Aitkin Countr's	Subaurface Sow	, 20 to certil	fy compliance\ noncompliance with tem Ordinance.
The premises of	overed by this co	age mealment bys artificate are legally	described as:
The premises co	overed by this ec	ortificate are legally	described as
Section	Township	Range	Lake
PERMIT NO		_ Owner Name	Lake
Address			
Installer Name _			
Type of System	Inspected		
Parcel Number_			
following: 1) Inspect	tion of the instal	lation or constructio	ee was based on No of the
reierence	a permit and ap	plication design.	
•	•		rdance with Subdivision 9.2 D of ent System Ordinance.
Altkiii Cot	arity 3 Oubsurfac	e ocwage meanic	in Oystem Ordinance.
Aitkin County's S shall serve as a	Subsurface Sewa Notice of Violation	age Treatment Syston:	t system is in noncompliance with tem Ordinance, then the following spections or investigations:
2) List of s	specific violation	s of Ordinance:	
3) Require	ements for corre	ction or removal of	violations:
4) Time so	chedule for com	pliance:	
turned over to the	ne Aitkin County	Attorney's Office for	will result in this matter being or further legal action, which may and/or imprisonment.
INSPECTOR SIG	GNATURE		

SUBSURFACE SEWAGE TREATMENT SYSTEM INSPECTION FORM AITKIN COUNTY, MINNESOTA

Township	_ Date of Inspection	App. Number		
Owner				
Project Address		Installer		
City	_ Zip Code			
New Repair	-	DIST. or DROP BOX & TYPE		
SETBACKS:		TRENCHES, BEDS, OR GRAVELLESS LEACHFIELD:		
Buildings to tank(s)		Trench/Bed depth		
Buildings to drainfield		Trench/Bed length		
Well(s) 50' or 100'		Trench/Bed bottom width		
Lake/Creek/Wetland		Trench spacing		
		Drainfield rock below pipe		
SEPTIC TANKS: New	Existing	Size of gravelless pipe		
Number of tanks installed		Depth of backfill		
iquid capacity and type		Absorption area: square feet		
Type of baffle		lineal feet		
nspection pipes		MOUNDS:		
Manholes size		Percent slope		
Manhole to grade Yes N	lo	Upslope sand width		
		Downslope sand width		
PUMPS: New	Existing	Sideslope sand width		
Tank capacity and type		Depth of sand below rock Perforation size & spacing		
Pump manufacturer & model #				
Horsepower & GPM				
Feet of head		Pipe size & spacing		
Gallons per cycle		Dimensions of rock bed		
Size of discharge line				
Type & location of alarm Water meter		Final cover		
Inspector's Comments:		nstaller's Signature		
Rev:1/13 Whit	te – County Yellov	v – Applicant Pink - Installer		

Site Drawing

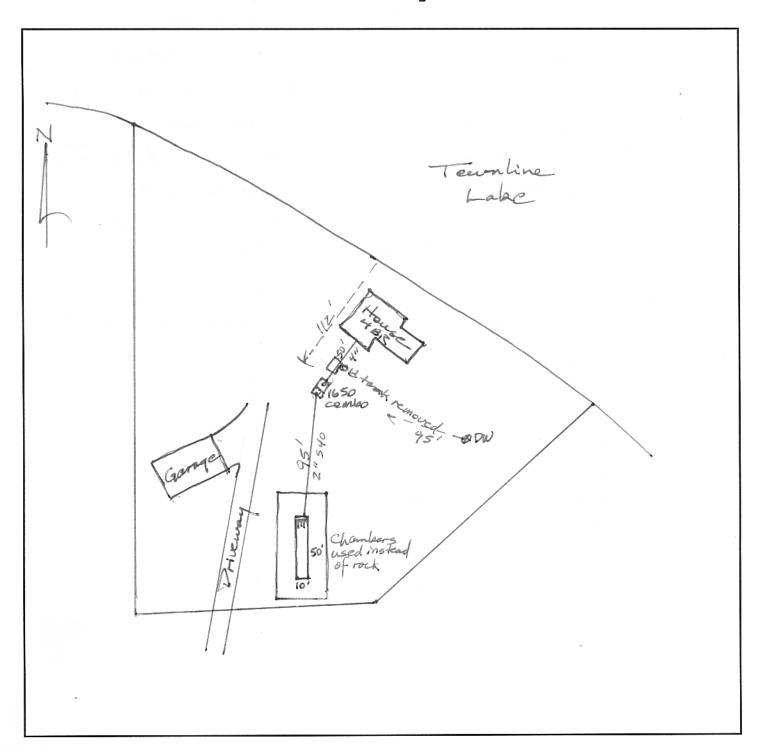

Notes				
			* ",	