

MARIS, KALVIN & ANN  
32317-395th Pl






Sewer Shelter 8' x 10'  
Distance from sewer tanks 20'  
Distance from mound - 48'  
Distance from Sewer Lake  
line 28'  
Distance from water  
180'

DATE 6/30/15  
revised ?

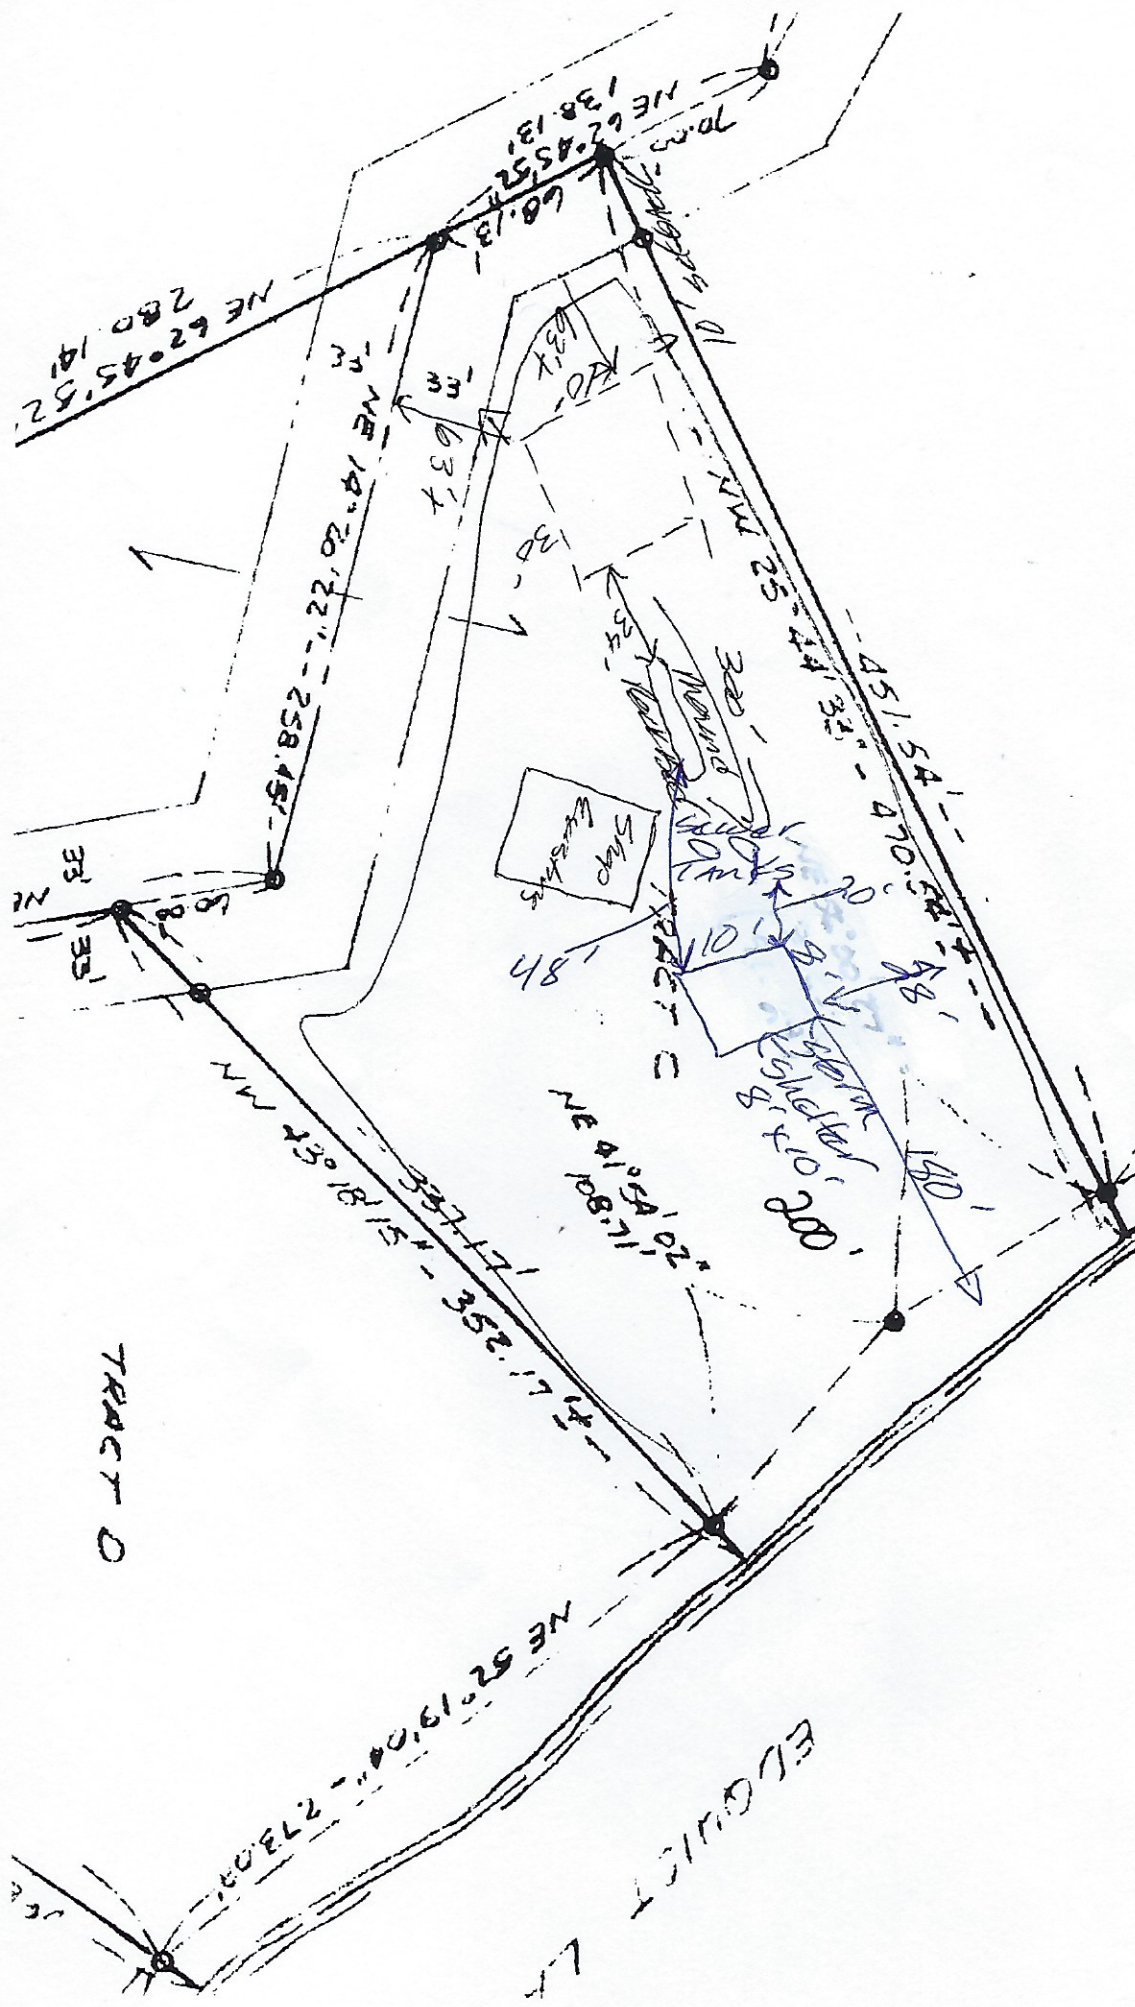

TRACT D

EL QUINCY LA