
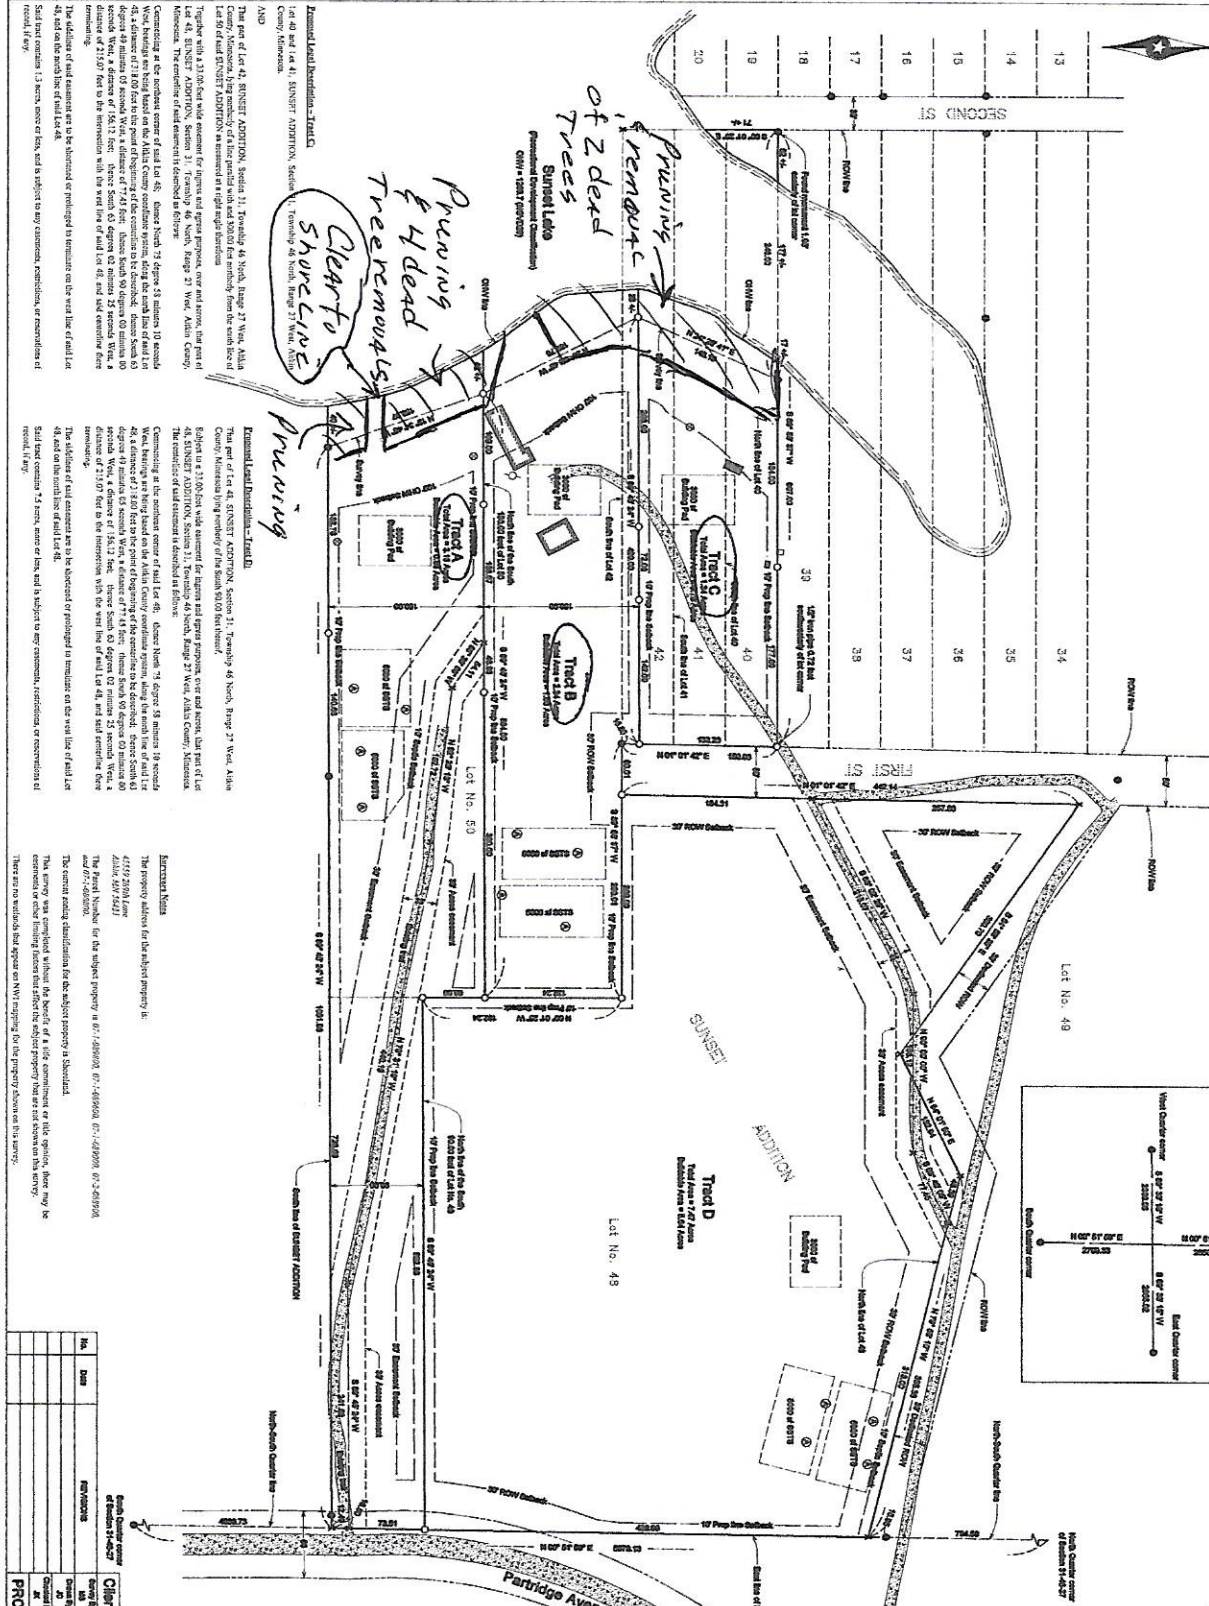


ORIG. Address: 45559 289th Ln.
 Veg. Alteration for Tract A, B, C

owner: Bruce Hawkins

Certificate of Survey

Part of Lot 40 - Lot 42, Lot 49, and Lot 60, SUNSET ADDITION
 Section 31, Township 46 North, Range 27 West,
 Aitkin County, Minnesota.

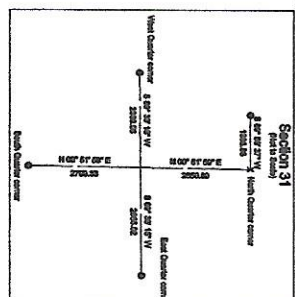













NO.	DATE	REVISIONS

Client Name: Bruce Hawkins
Client Address: 45559 289th Ln., Aitkin, MN 56441
Project No.: HAWK61901



