




Prop line



100'

30x60

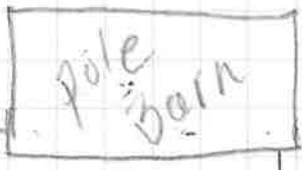

pole Barn



85'

30x30




Cabin



Pond

85'

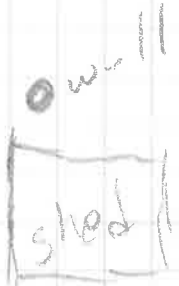

shed

25'

70'

160th street