


Ranushka, Darlene - Site Plan  
 PID# 11-1-111300  
 Total lot size = 23,958 sqft.

House = 1,583  
 Lake Deck = 240  
 Front Porch = 82  
 Driveway = 720

Total 2,625 sqft  
 23958  
 = .1095 or 11%  
 Impervious

Big Pine Lake

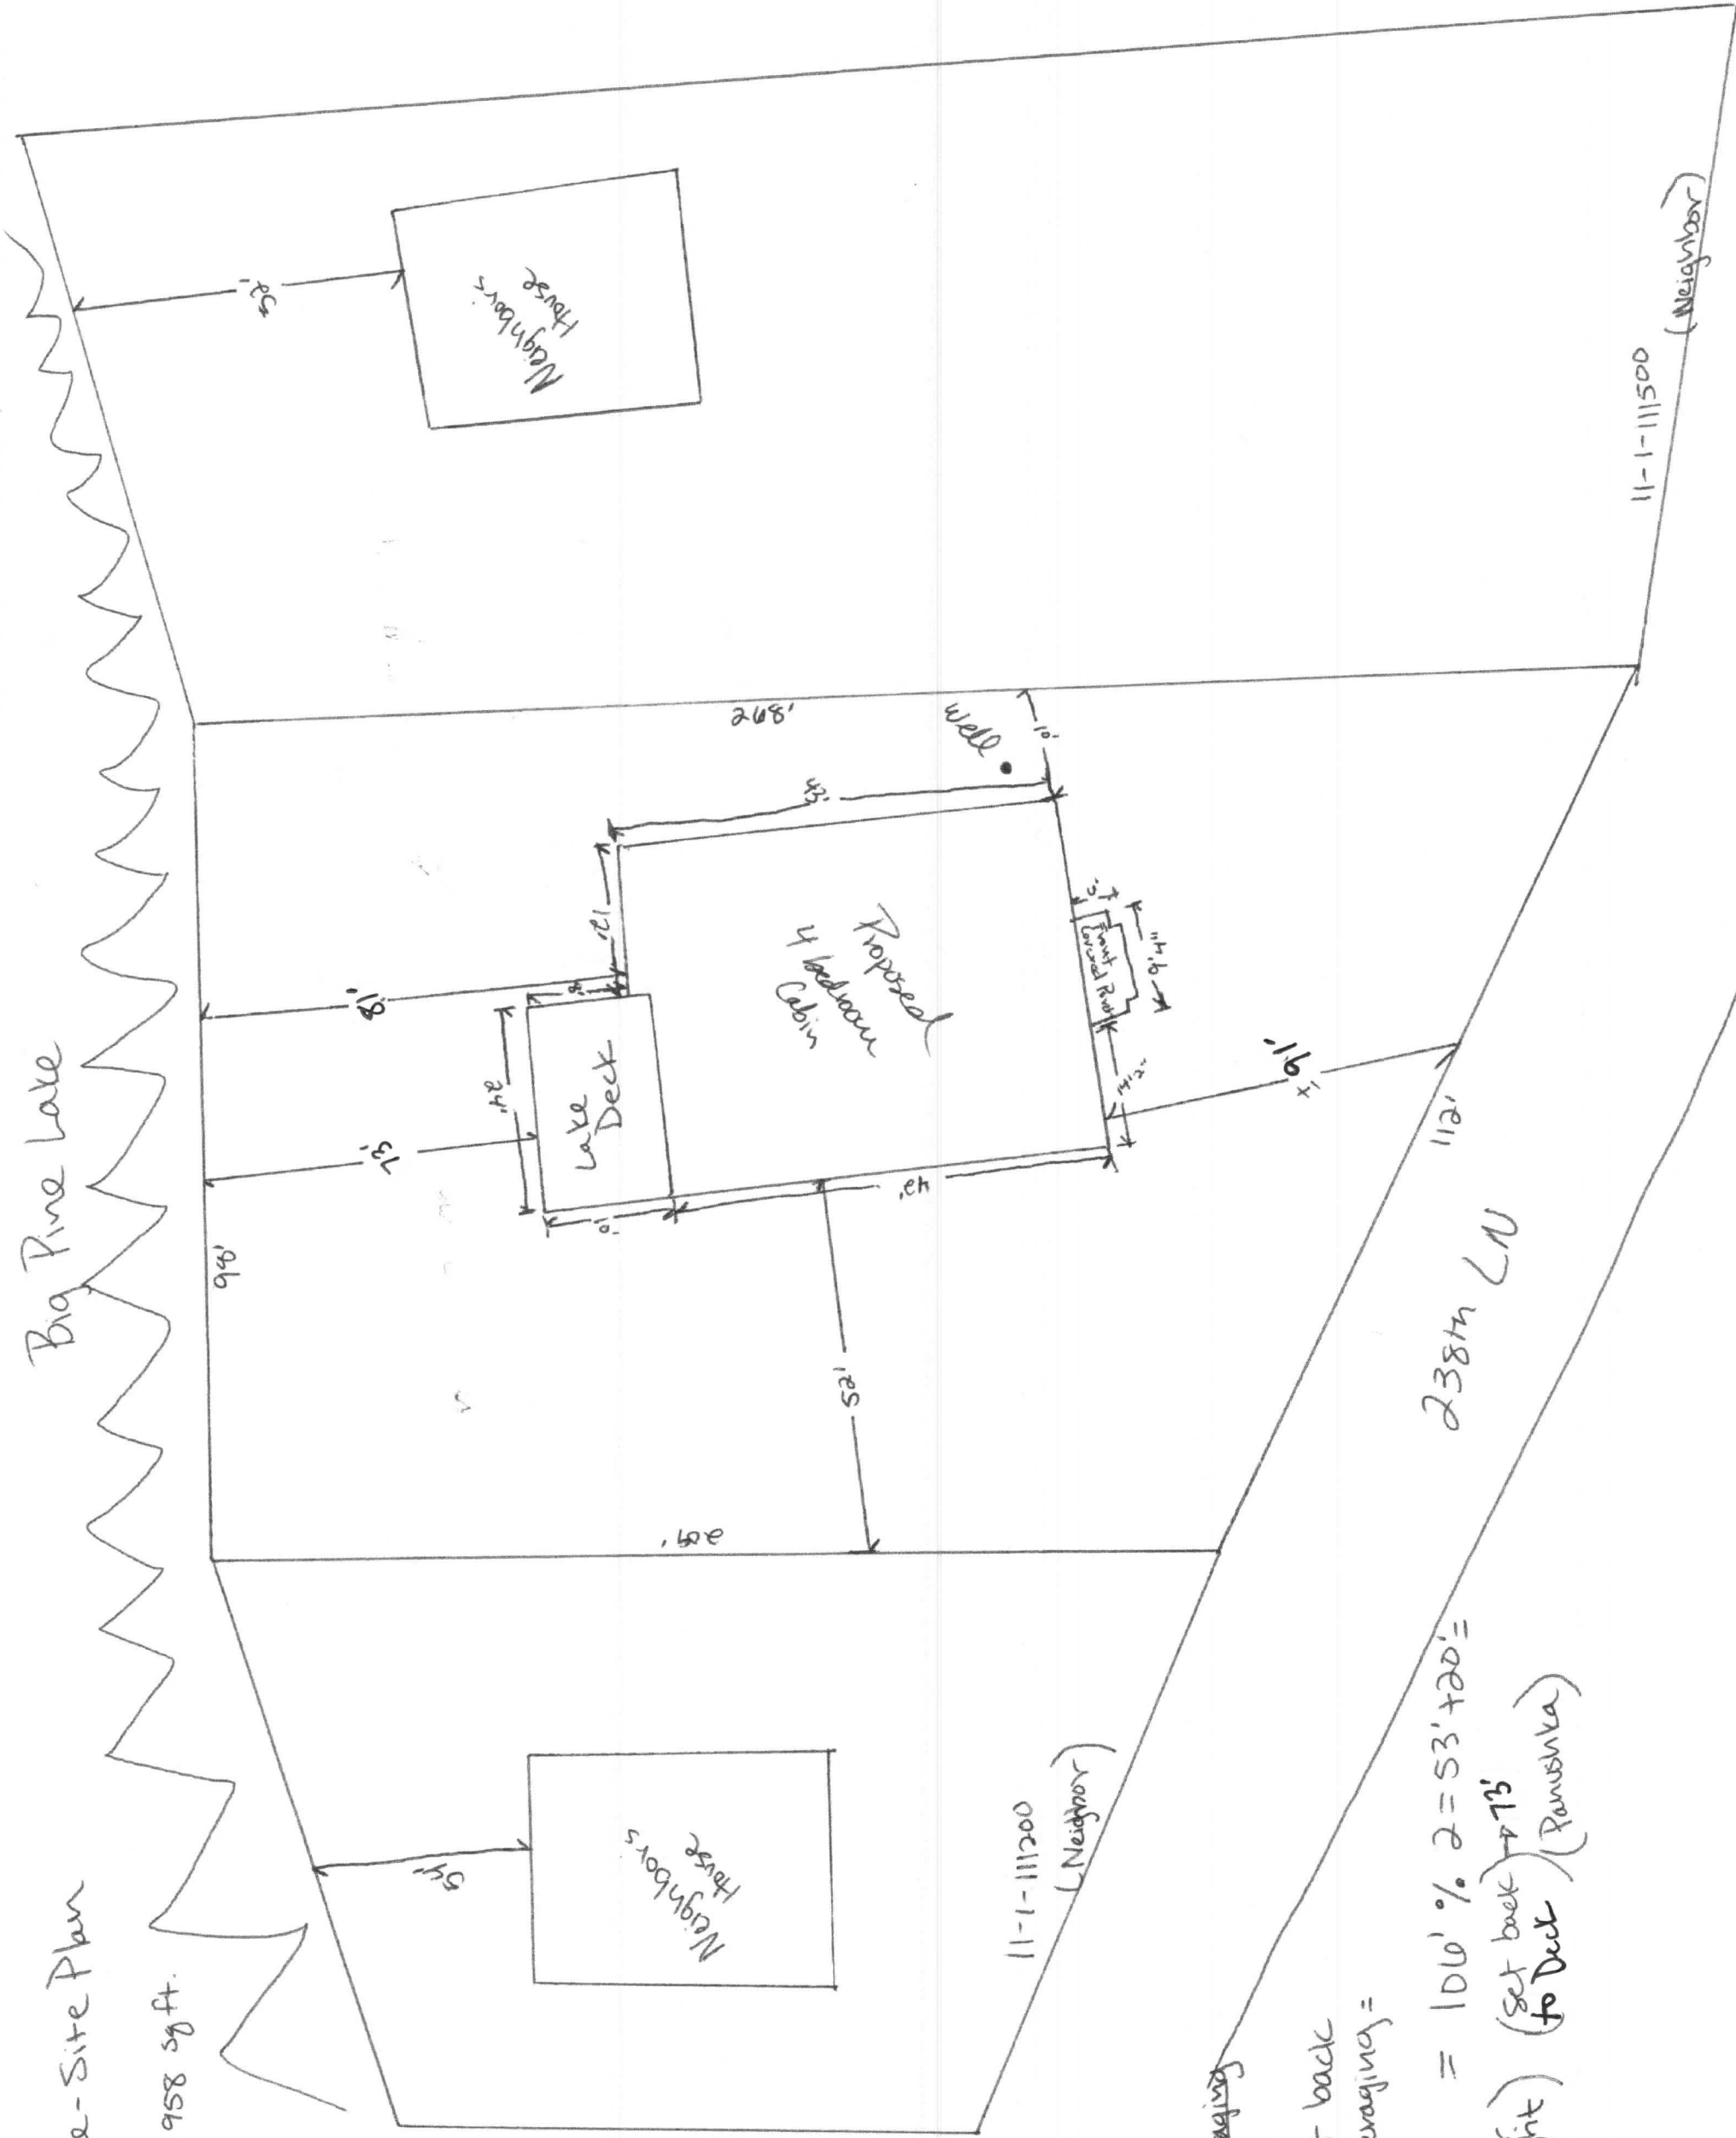

Request for Lake Averaging

Please Note Lake Set back  
 is based on lake averaging =


(Neighbor to Left) (Neighbor to Right) (Set back to Deck) (Ranushka)

238th LN