


20385 485 TH ST.
MCGREGOR, MN. 55760

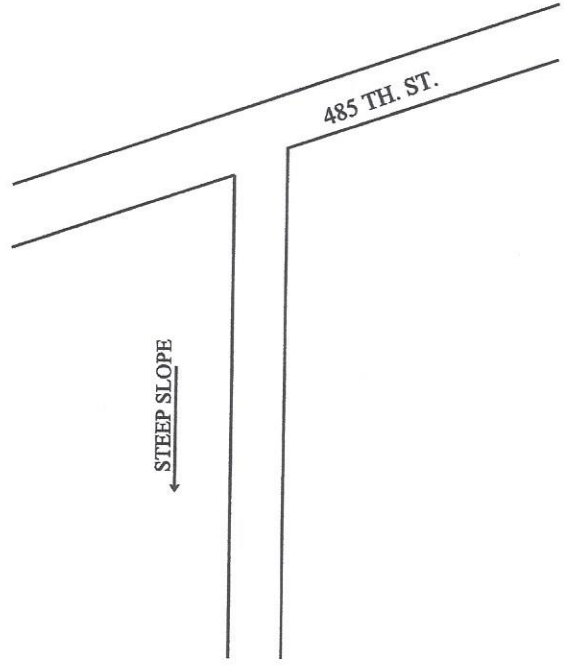


PROPERTY LINE



20'+

10'+

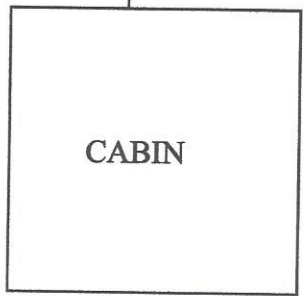

75'+
TO WELL

WELL
X

LAKE

