


112'


332'

N

220'

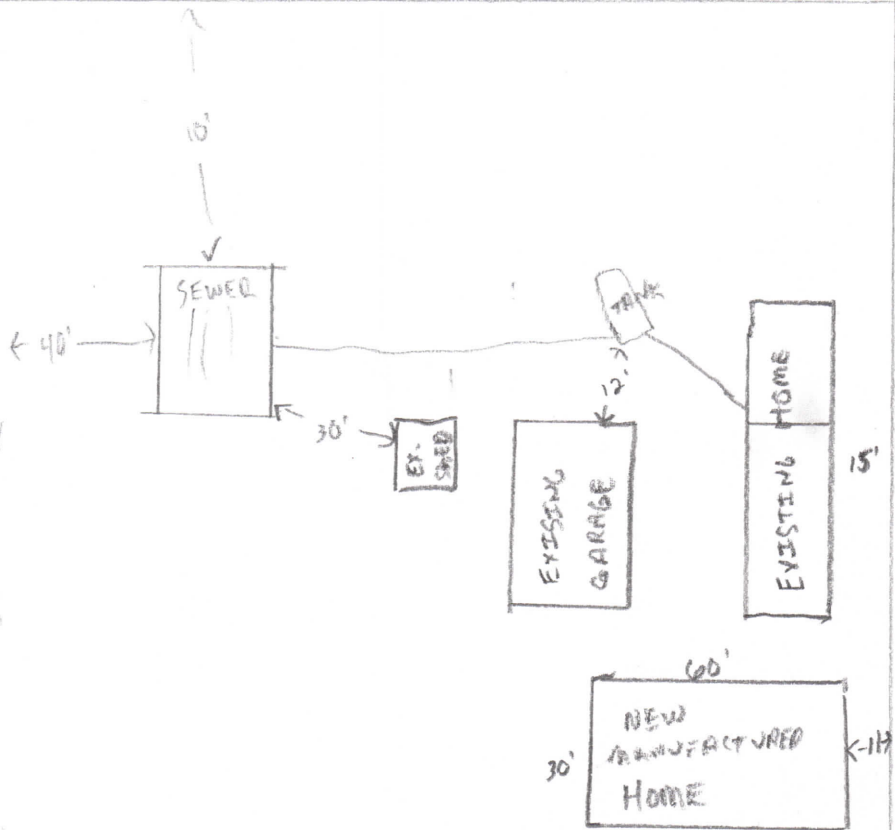

217th AVE

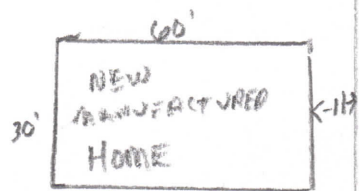

200' 4

200' 4

112'

332'

220'