


↑
300' P.L.

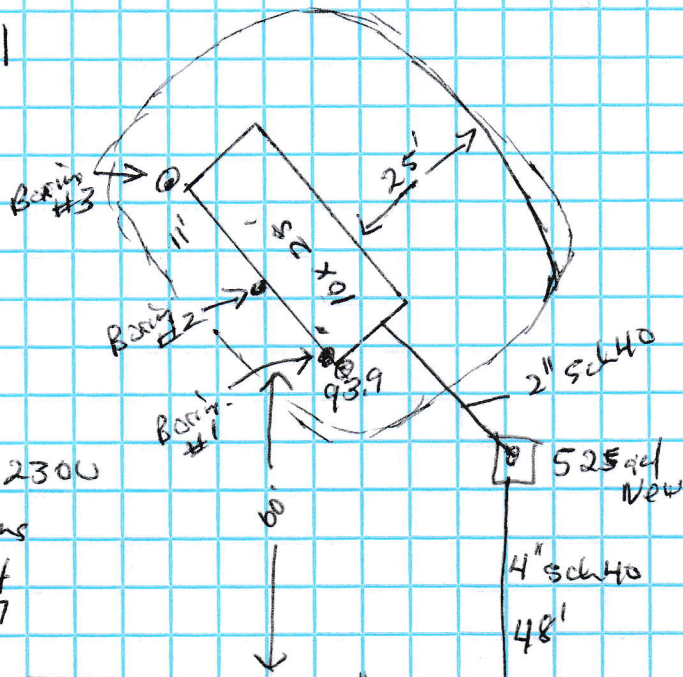

Parcel # 12-0-02300

Loree Williams

320-266-3394

Tony 320-267-4617

Bcky 320-240-0011

← 40' P.L.

N
↑

20' per Inch

26 Garage Existing

38

← toward walk

Home Ev. 40'

20'

Porch 5'

EL 100
Ex 100gal Tank

← 23' →

P.L.

Driv

Deep Well

↓
100' RW